
T. 5 N., R35 E., W.M.

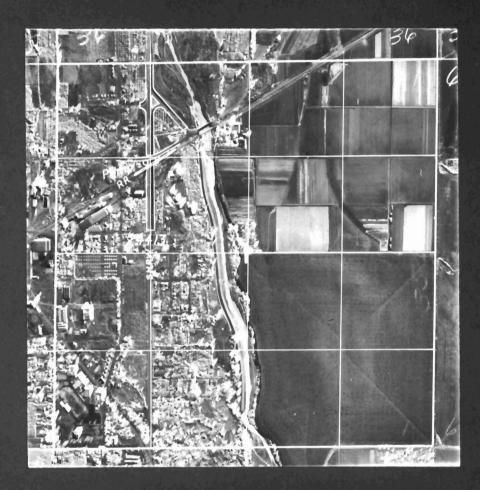

FINAL PROOF SURVEY

UNDER

Application No. 20013 Permit No. 19253 IN NAME OF

State Highway Commission

Surveyed May 19 1954, by T. Jones NZ-4F-184