


T.14S. R.1E. - 1W.W.M.

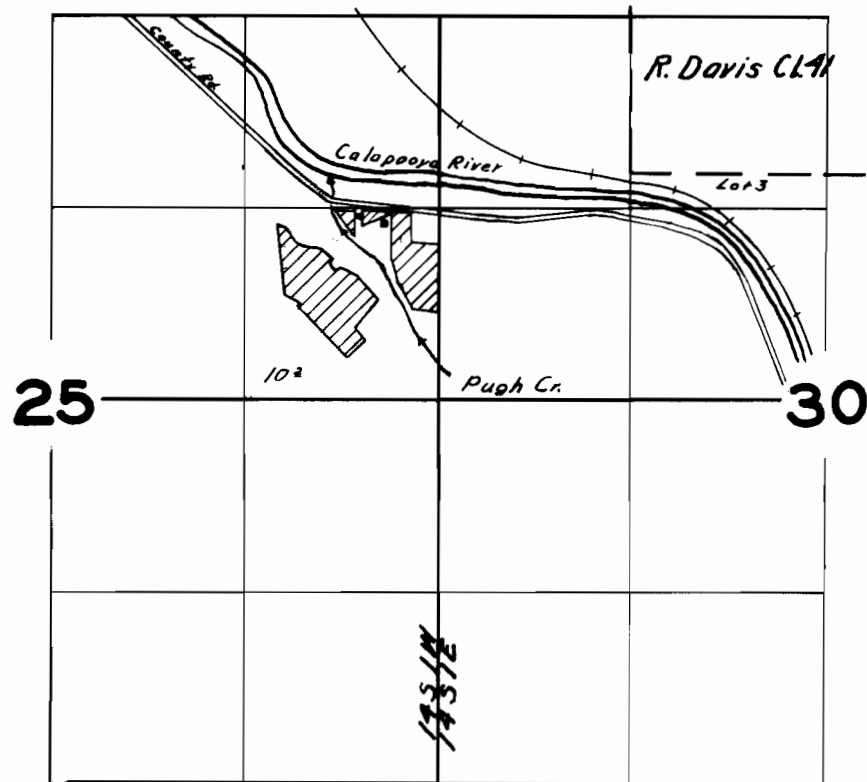

FINAL PROOF SURVEY
UNDER

Application No. 24720..... Permit No. 19490.....
IN NAME OF

..... J. S. KING

Surveyed July 20, 1951, by Geo. Nademan