


T.30 S.R.5W.W.M.

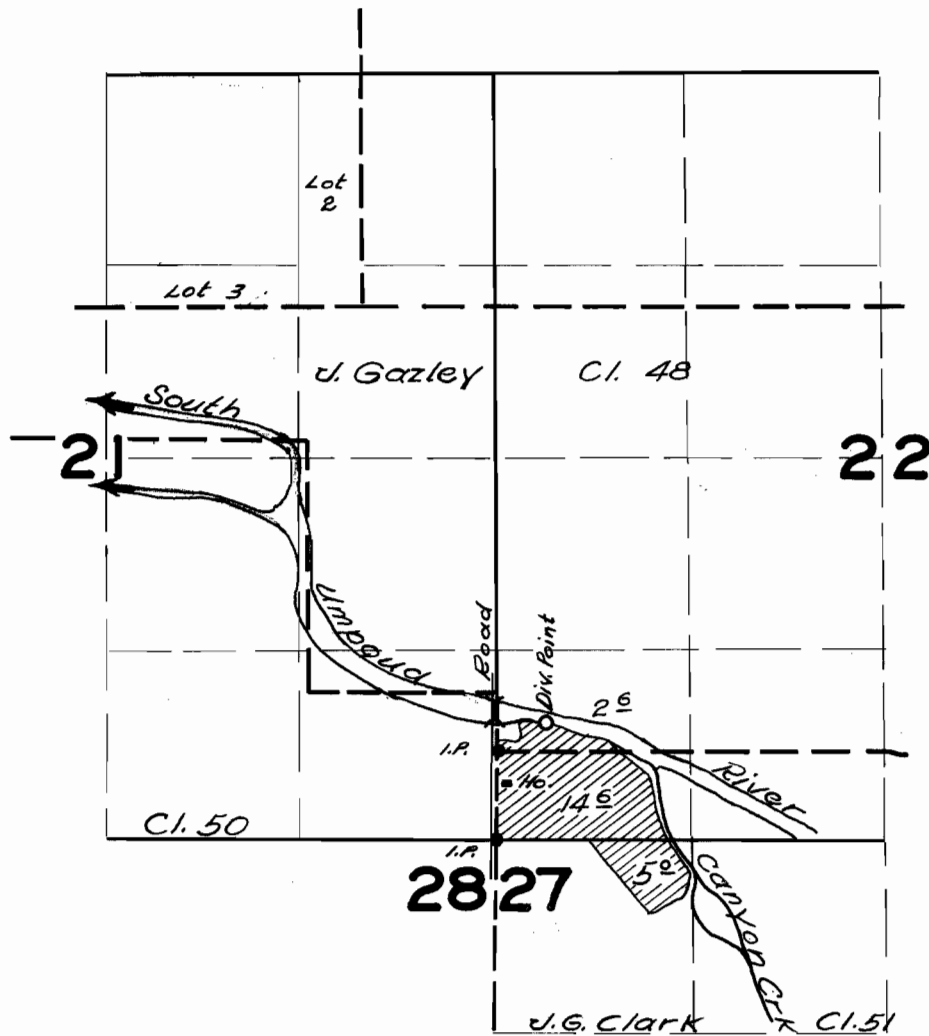

FINAL PROOF SURVEY

UNDER

Application No. 25221 Permit No. 19820

IN NAME OF

Lloyd G. Lyman

Surveyed July 24, 1954, by H. L. Coffman