


T.29 S.R.5 W.W.M.

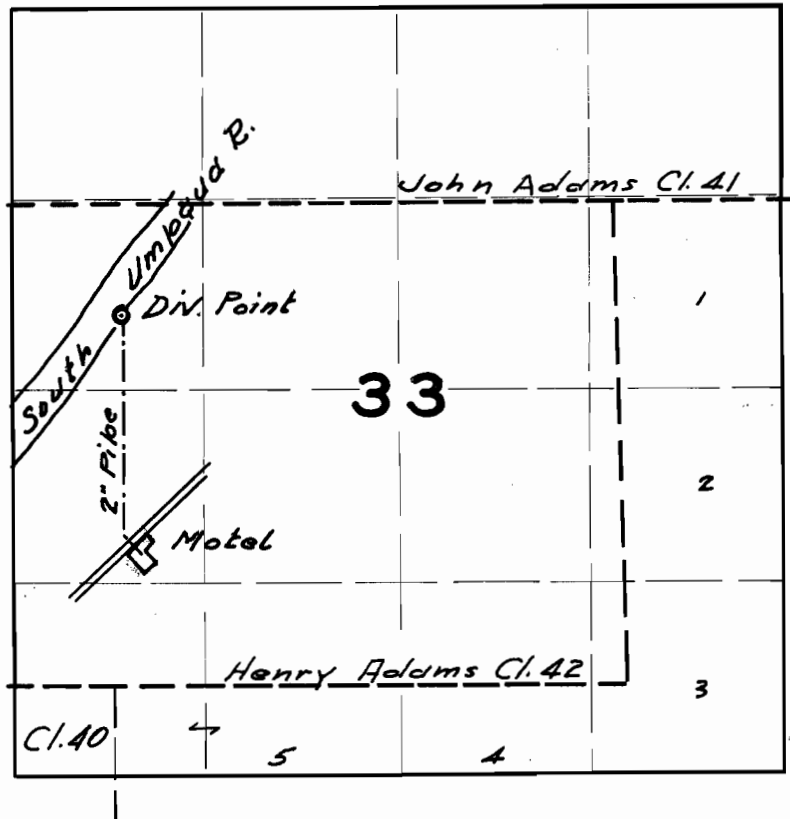

FINAL PROOF SURVEY

UNDER

Application No. 25247..... Permit No. 19833.....
 IN NAME OF

..... Alf Hornseth & Gordon D. Brown

Surveyed July 23 1954., by H. L. Coffman