


T. 18 S. R. 2 W. W.M.

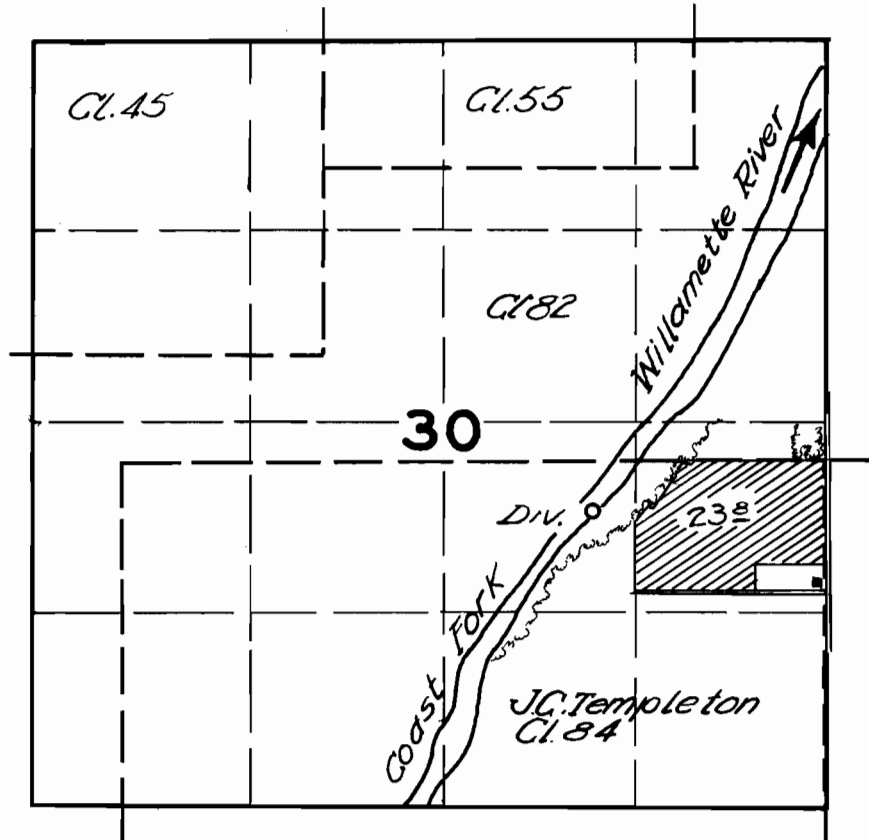

FINAL PROOF SURVEY UNDER

Application No. 20246 Permit No. 20452
IN NAME OF

..... ran *Peymer*

Surveyed *11/2* 19 *54*, by *.....* *.....* *.....*