


# T9S.R.4W.WM

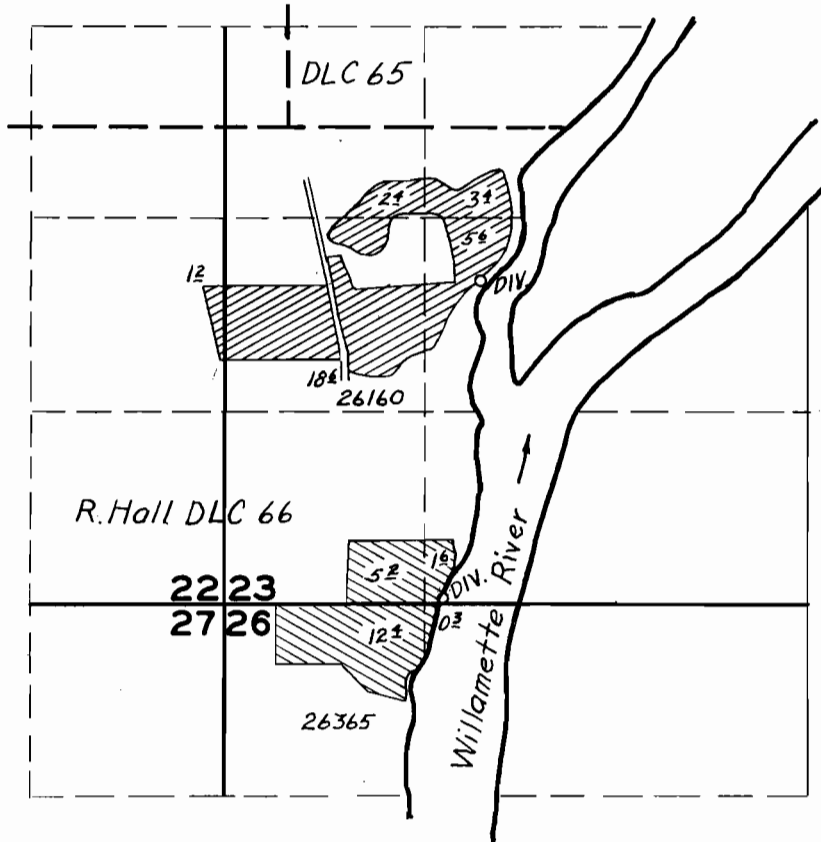

## FINAL PROOF SURVEY

UNDER

26160 11410  
Application No. 26365 Permit No. 20691

IN NAME OF

John and Mary Brazdoff  
Leo and/or My Jane Brazdoff

Surveyed Aug. 18, 1954, by T. Jones