


T.19S.R.1W.WM

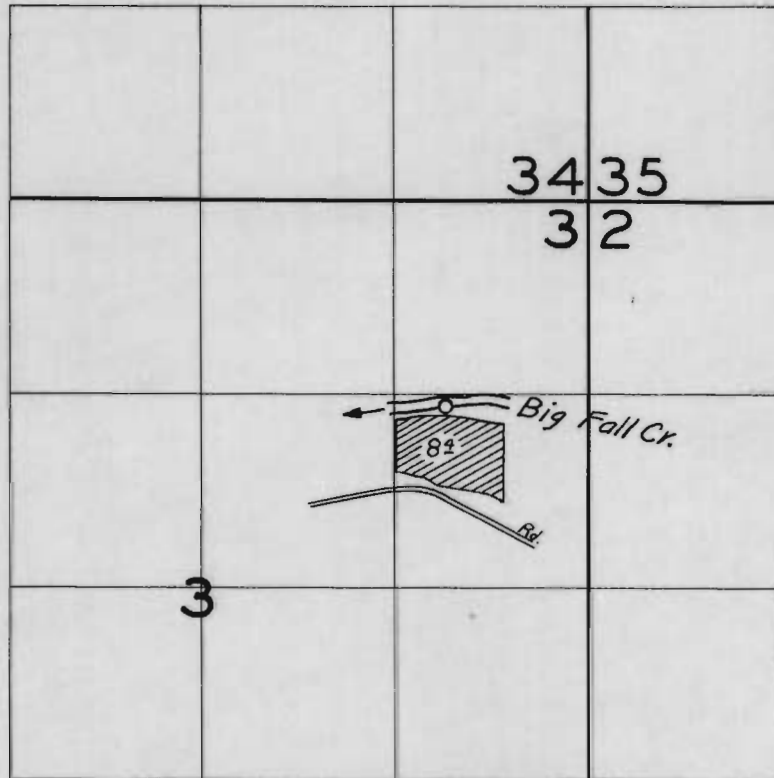

FINAL PROOF SURVEY

UNDER

Application No. 26972 Permit No. 21187

IN NAME OF

Earl Drury

Surveyed April 29 1954, by T. Jones