


T.18S. R.10W. WM

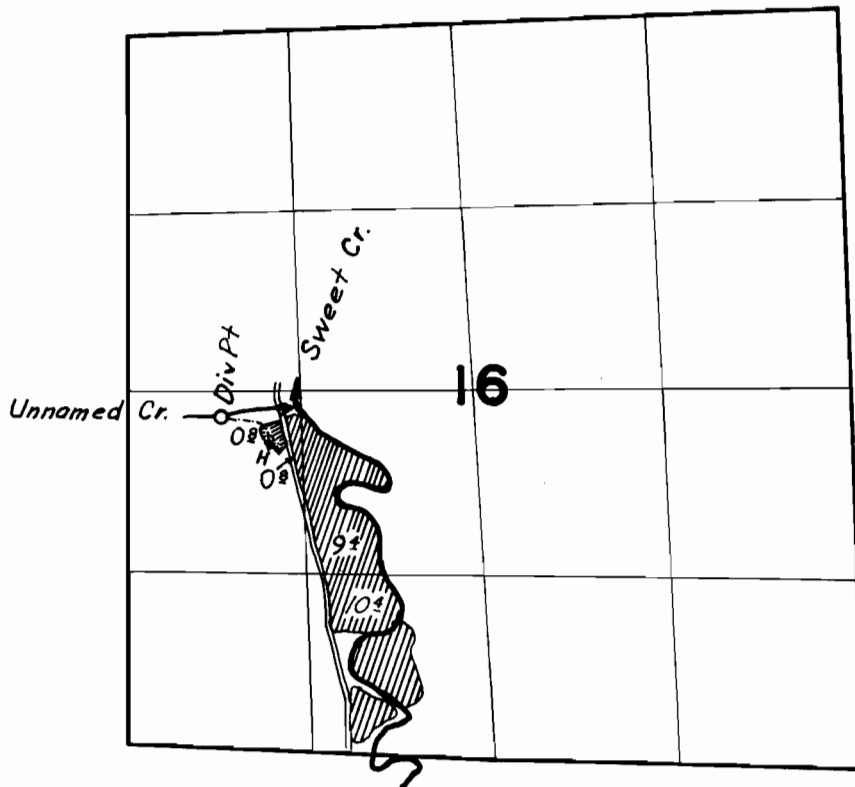

FINAL PROOF SURVEY

UNDER

Application No. 27193..... Permit No. 21347.....

IN NAME OF

..... Fischer

Surveyed August 19, 1904, by