


T9S.R.4W.WM

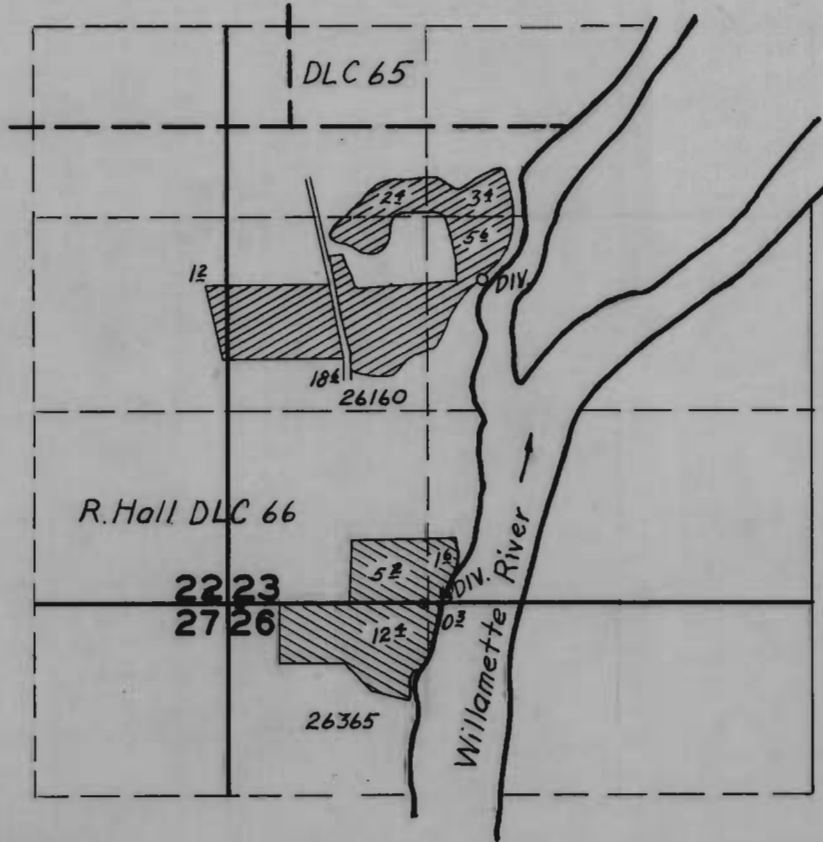

FINAL PROOF SURVEY

UNDER

Application No. 26160..... Permit No. 21510
26365..... 20691

IN NAME OF

John and Mary Drazdoff
Leo and/or May Jane Drazdoff

Surveyed Aug. 18, 1954, by T. Jones