


T. 17 S., R. 6 W., W.M.

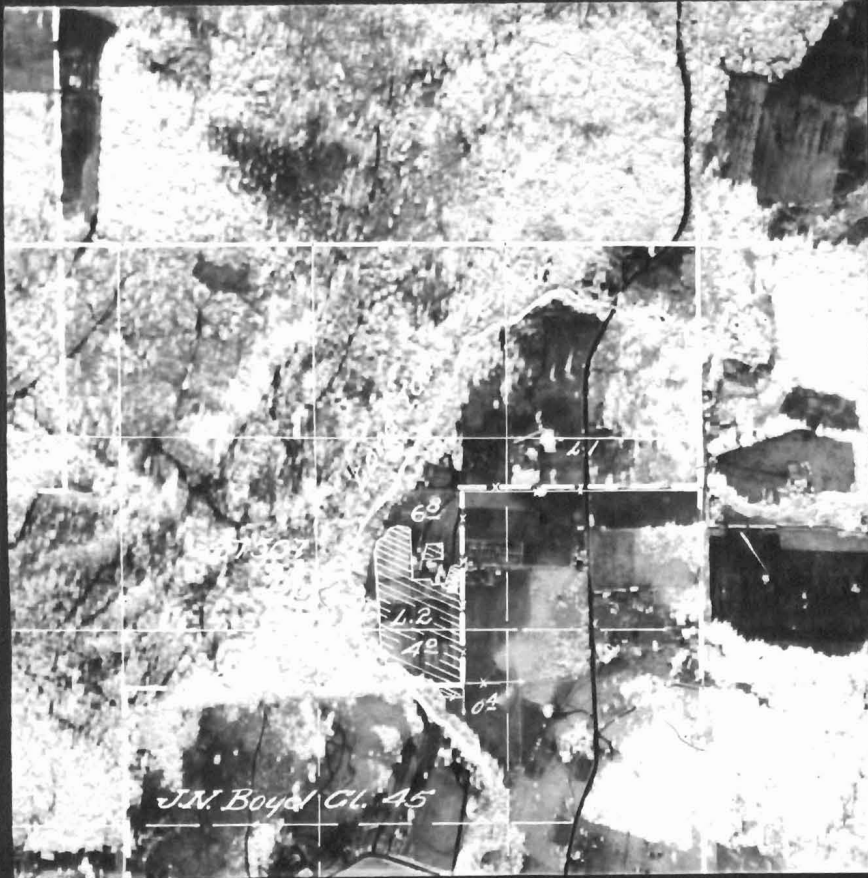

FINAL PROOF SURVEY
UNDER

Application No. 27507..... Permit No. 21645.....
IN NAME OF

.....Lawrence Fox.....

Surveyed April 23 1954..... by H. L. Hoffman.