


T.16S.R.7W.WM

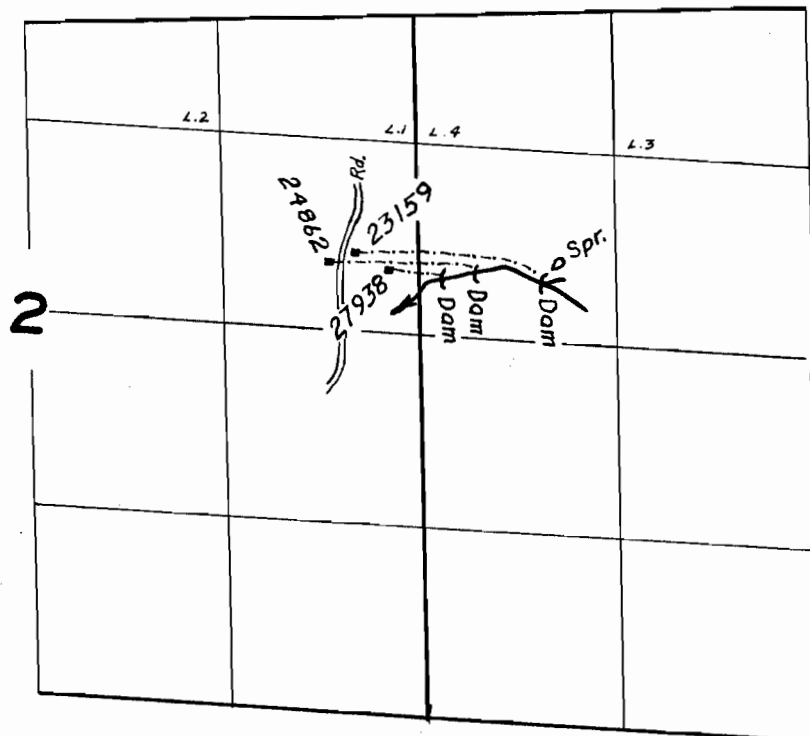

FINAL PROOF SURVEY

27938
24862

22107
19677

Application No. 23159... Permit No. 18243...

Wayne C. Betts

Andrew J. Hamper

Walter E. Robertson

Surveyed April 2, 1954, by ...