


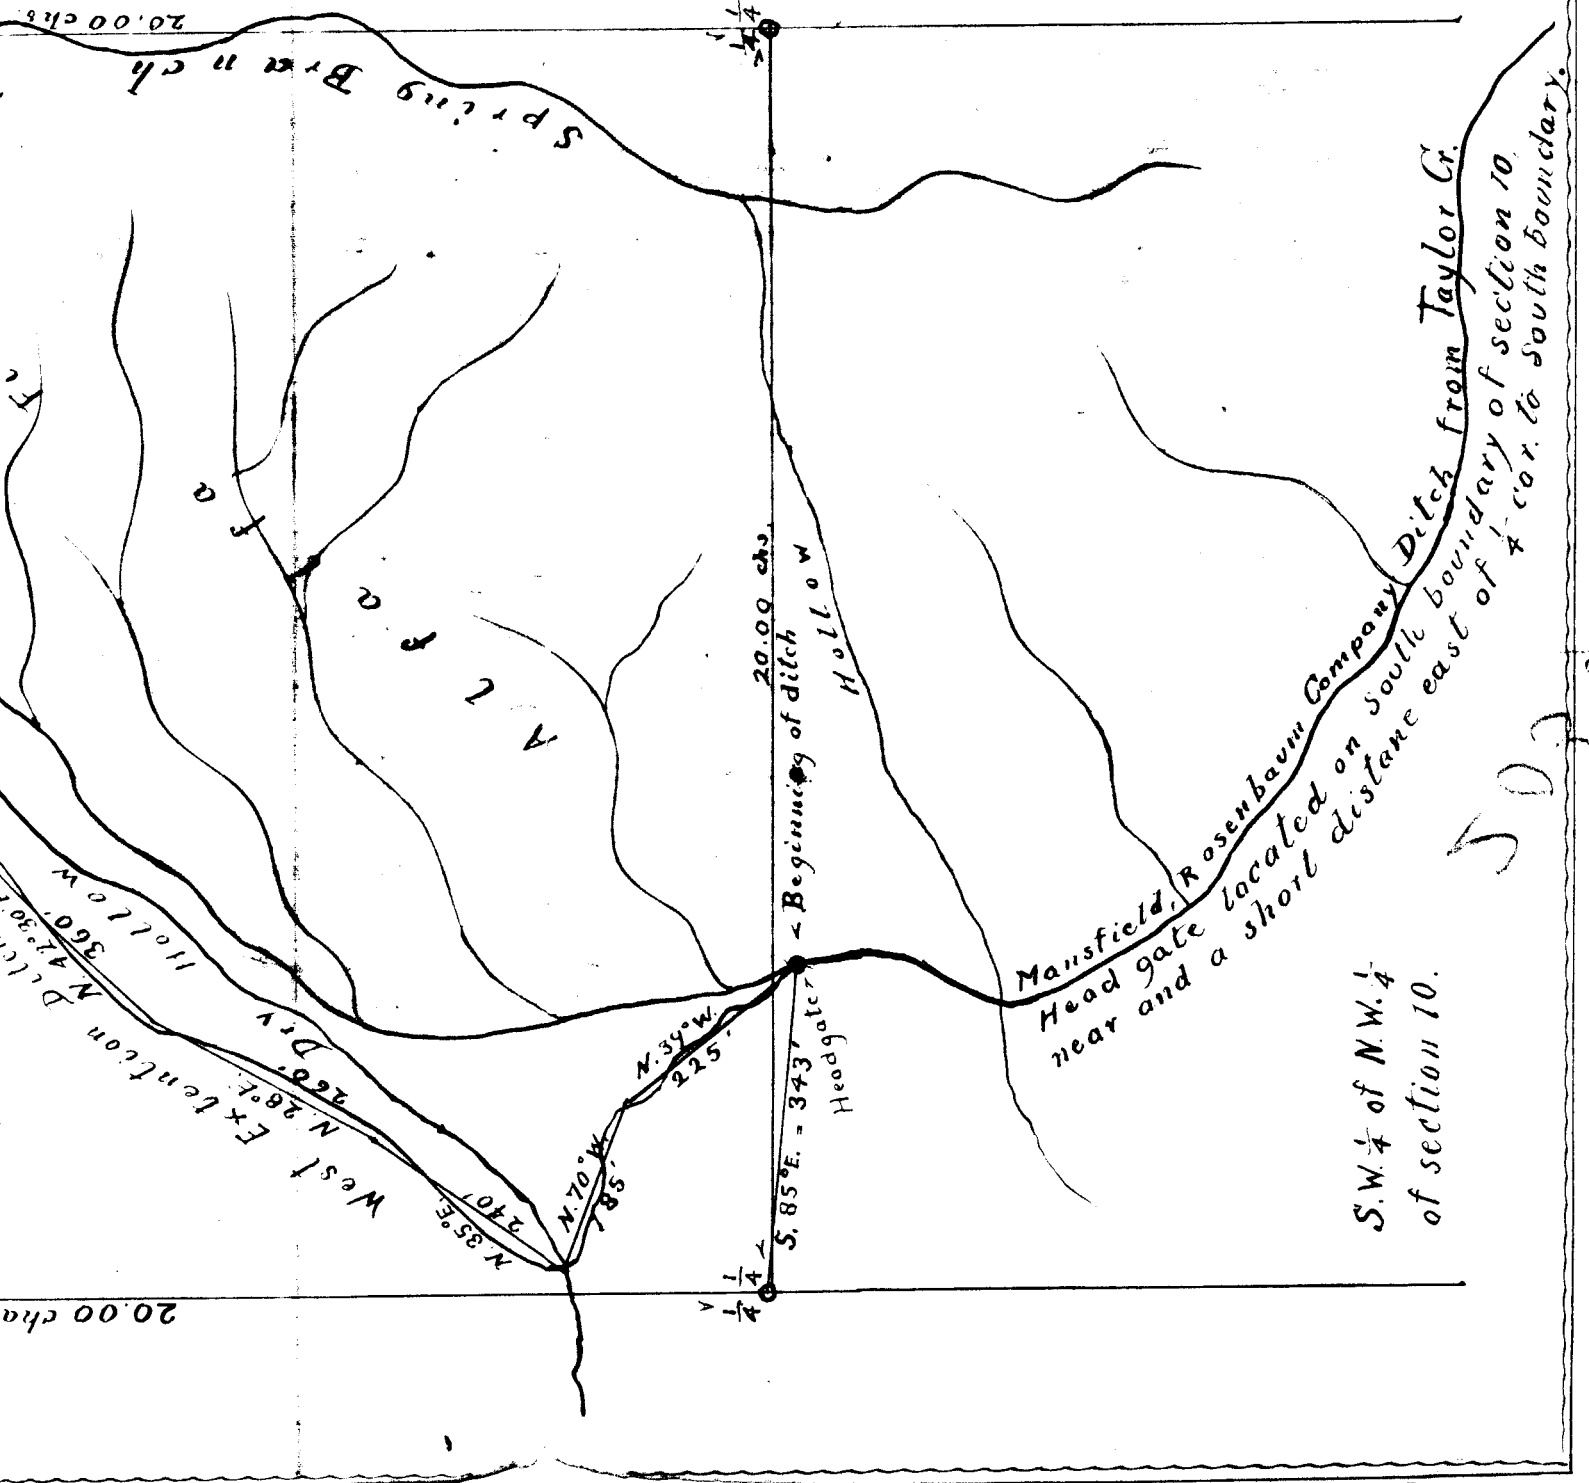

S.W. 1/4 of N.W. 1/4 of section 10.

507-20

I, *A. J. C. McMillan*, of Fossil, Oregon, do hereby certify that this map was made from notes taken during an actual survey made by me on April 13th 1911, and that it correctly represents the works described in the accompanying application, together with the location of streams and other ditches in the immediate vicinity, and has written thereon the area in each smallest legal subdivision which it is proposed to irrigate.

A. J. C. McMillan
Surveyor.

Scale 1' = 200'

Life between sec's 3 and 10
 Tpx { 2-6 Range 20 E. W.M.


