


Permit 5838
21130

of
John Day Water System
John Day City, Ore. Appropriator.
Scale 4"=1 mile.

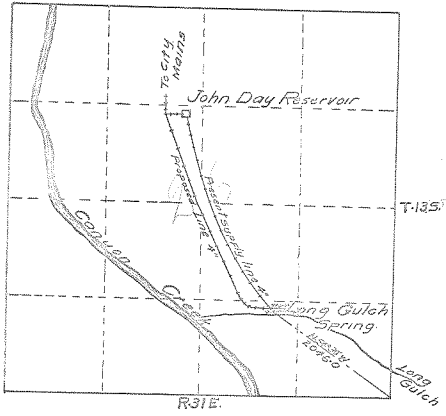

I, Vernon L. Glaze, hereby certify that I made this map from notes taken during an actual survey made by me on April 2, 1923 and that it correctly represents the works described in the accompanying application.

No. 431

Vernon L. Glaze
Registered Professional Engineer.
NOV. 25, 1919

T. 13 & R. 31 E.

Vernon L. Glaze

STATE ENGINEER
JAN 25 1923
SALFORD, OREGON

Application No. 8875
Permit No. 5838