

5

6

Approx. Creek Loc.

T. 4 S. R. 11 E.
T. 4 S. R. 12 E.

T. 4 S. R. 11-12 E. W.M.

FINAL PROOF SURVEY
UNDER


APPLICATION NO. ²¹⁹²² 23708 PERMIT NO. ¹⁷⁵²² 17848
_{R-22496 R-896}

IN NAME OF

H. L. and Alda I. Marrow

SURVEYED June 14 1954 BY *H.L. Coffman*

CCJ 1F119, 1954A

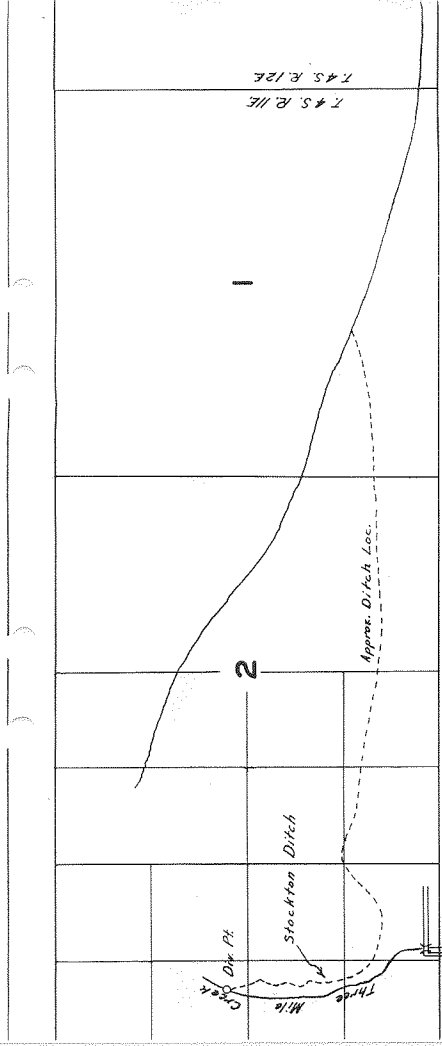

T 4 S. R. 11 E
T 4 S. R. 12 E

1

2

Approx. Ditch Loc.

Div Pt
Creek

Stockton Ditch

Three Mile

T. 4

FIN

APPLI

SURV

