
T. 22 S., R.321/2.EW.M.

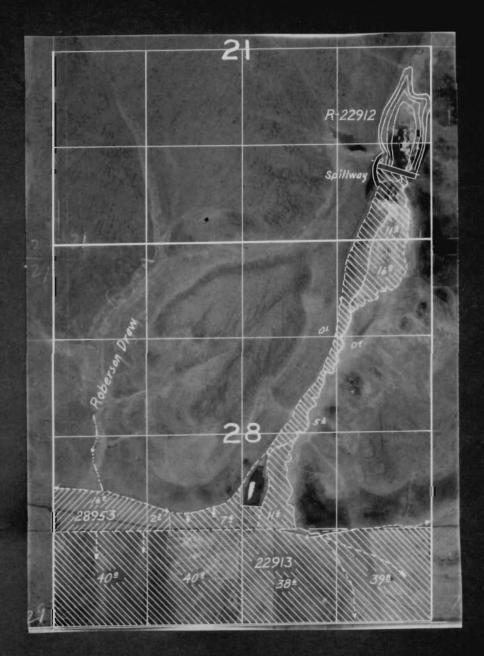

FINAL PROOF SURVEY

UNDER
22913 18065
28953 22772
Application No.R-22912 Permit No. R-915

Frank Smith

Surveyed June 25. 19.54, by .T. Jones

H2-9-8