


T.6S.R.6 W.WM

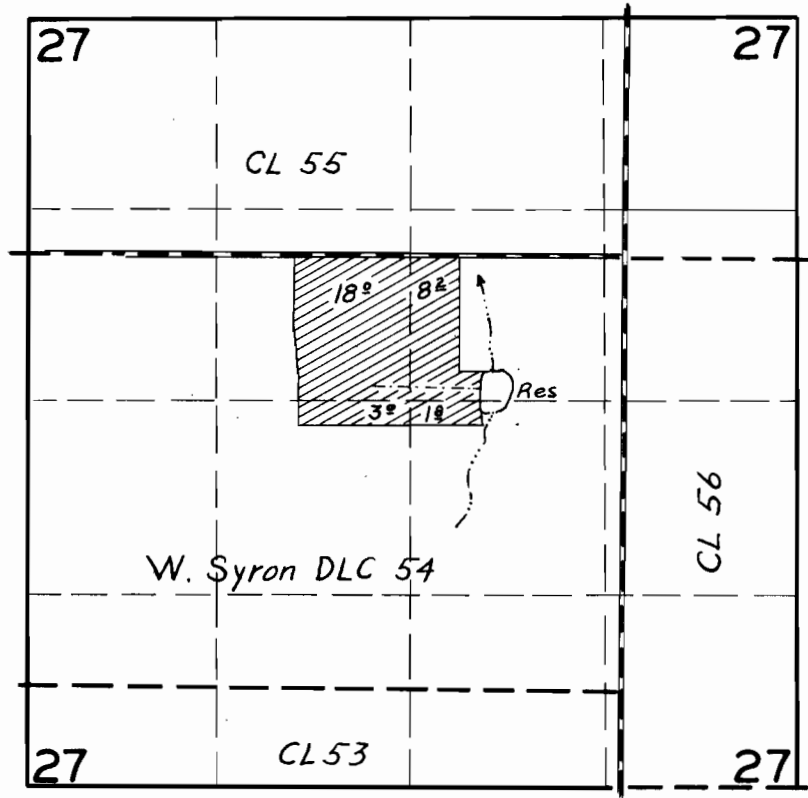

FINAL PROOF SURVEY

UNDER

24807

20197

Application No. R-24806 Permit No. R-1127

IN NAME OF

Herman Endres

Surveyed July 13 1954, by T. Jones