


T.6S.R.6 W.WM

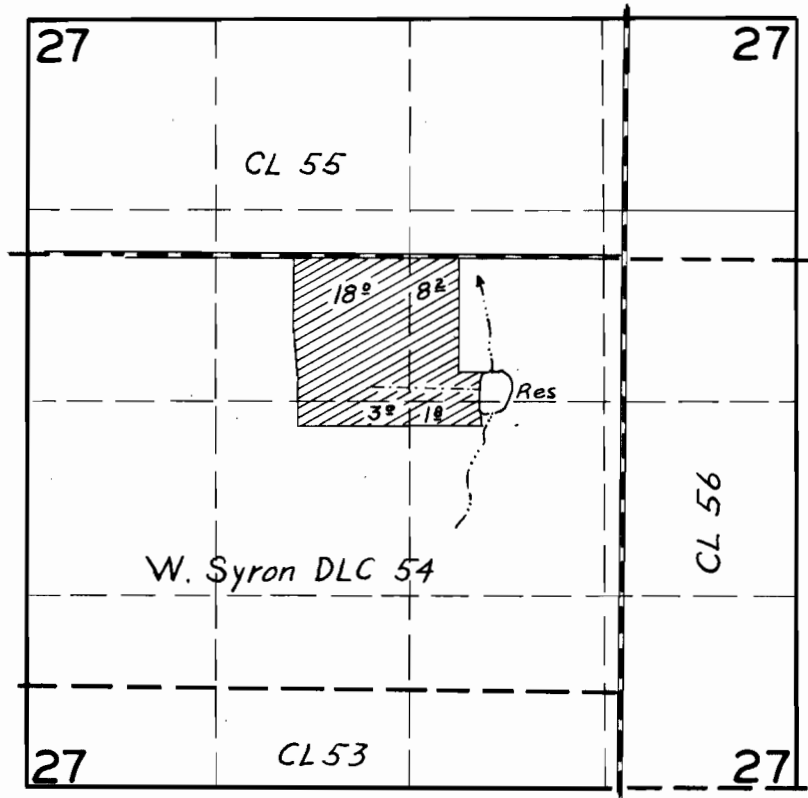

FINAL PROOF SURVEY

UNDER

24807

20197

Application No. ~~R-24806~~ Permit No. ~~R-1127~~

IN NAME OF

..... Herman Endres

Surveyed July 13, 1954, by T. Jones.....