


T.7S.R.1E.WM

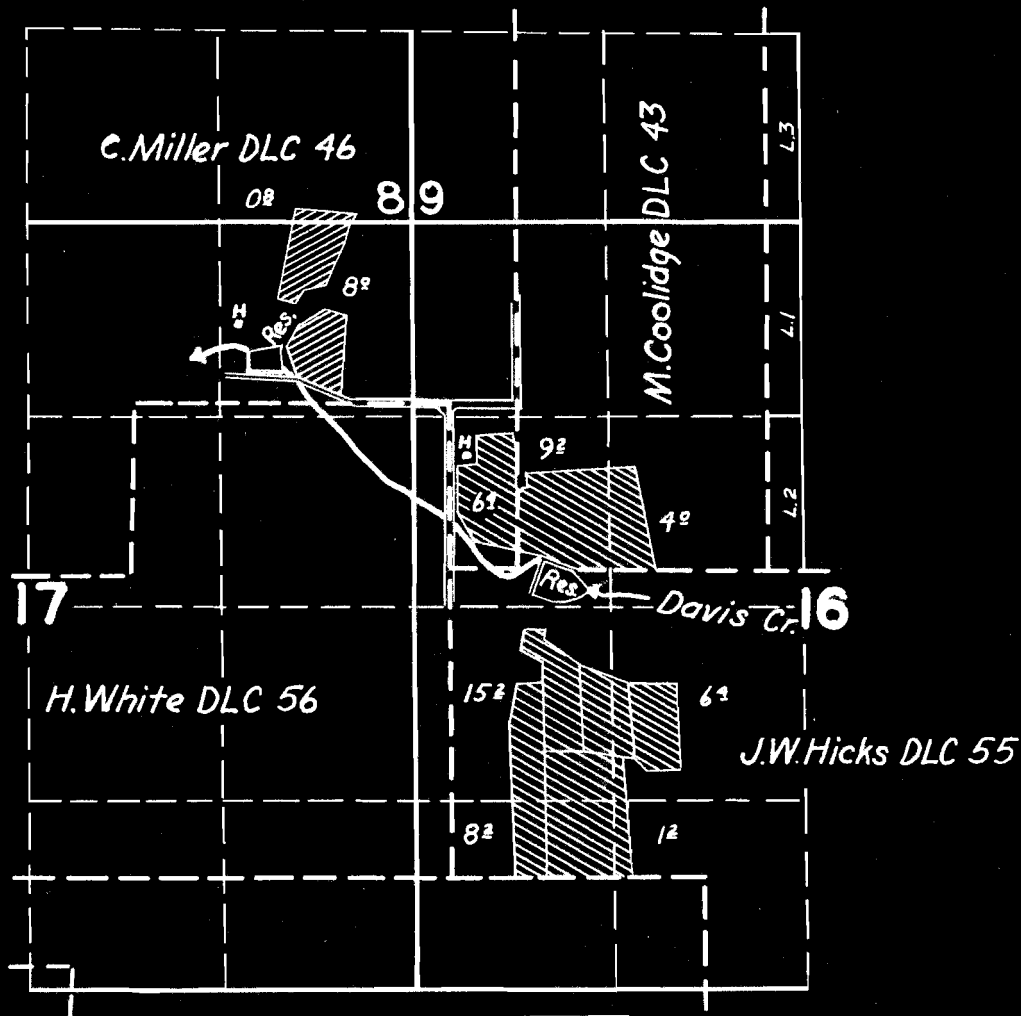

Appl. No. 26073



Appl. No. 24331



FINAL PROOF SURVEY

R-26072

R-1121

26073

26073

R-24330

R-2021

Application No. 24331 Permit No. 12342

IN NAME OF

Clay Porter

Victor J. Hadley and W.A. Tschant

Surveyed May 27, 1951, by T. Jones