


T. 7 S., R. 1 W., W.M.

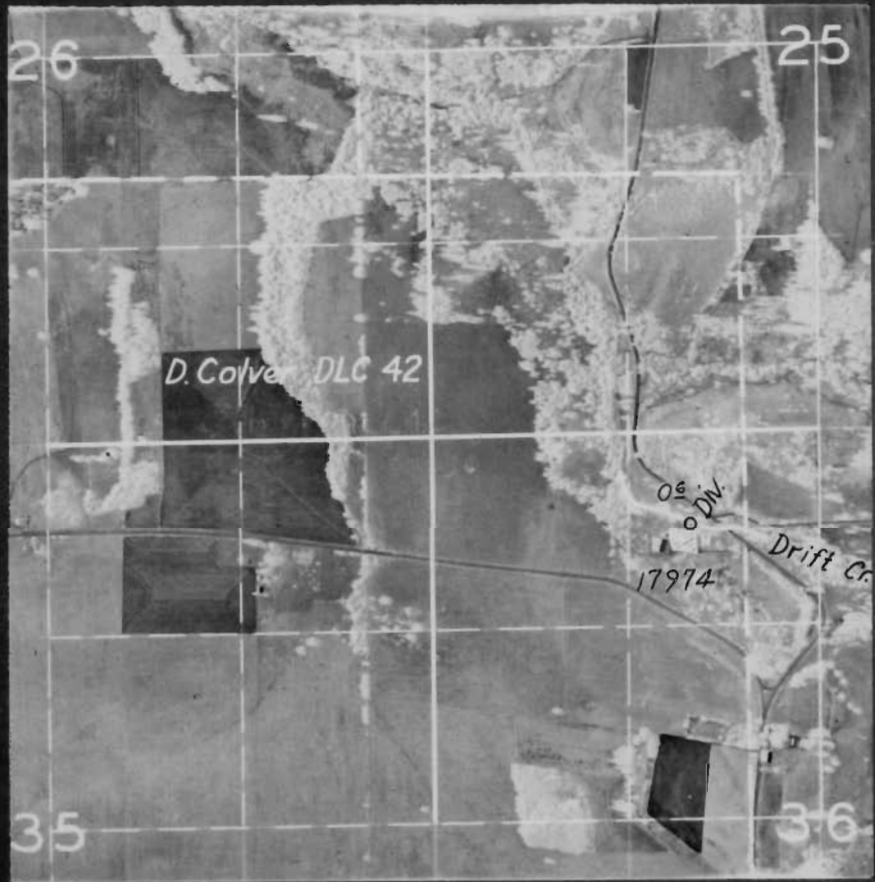

**FINAL PROOF SURVEY**  
UNDER

Application No. 17974 Permit No. 13649  
IN NAME OF

Elmer Lorence

Surveyed May 28, 1954, by H. L. Coffman

DFN 5D 01