

T. 6 S., R. 1 W., W.M.



## FINAL PROOF SURVEY

UNDER


Application No. 19856..... Permit No. 15435.....

IN NAME OF

..... St. Benedicts Abbey .....

Surveyed May 27..... 1954., by H. L. Coffman

# T.6S. R.1W.W.M.

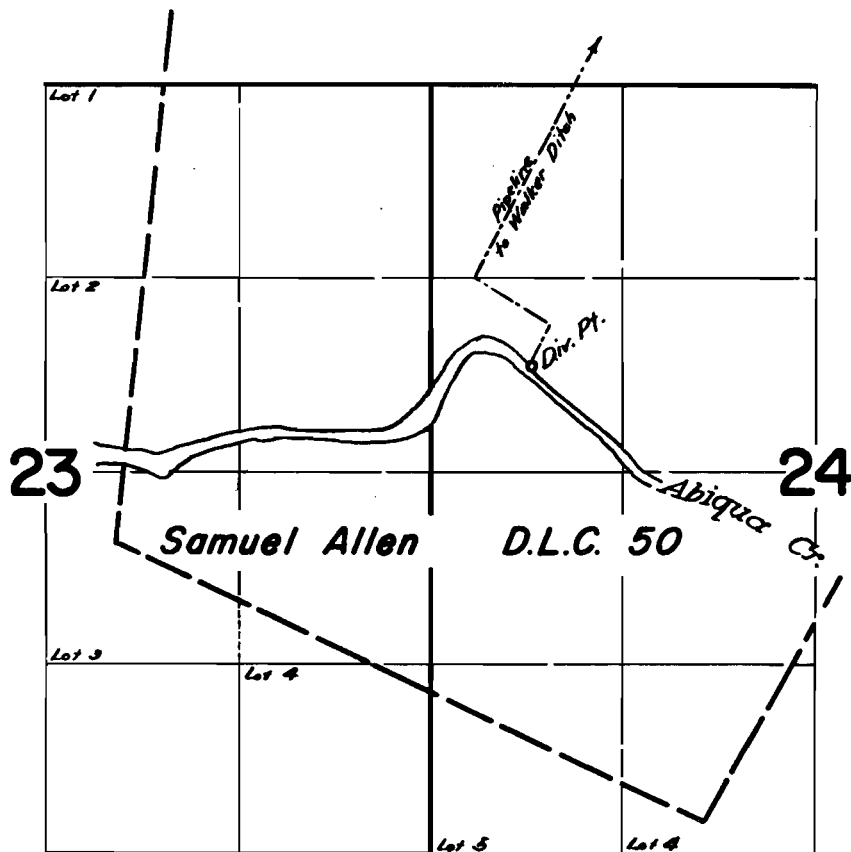

## FINAL PROOF SURVEY UNDER

TRANSFER M-121

Application No. .... Permit No. ....

IN NAME OF

MT. ANGEL ABBEY

Surveyed April 16, 1962, by *R. H. Jackson*