


T.27 S.R. 2W. WM

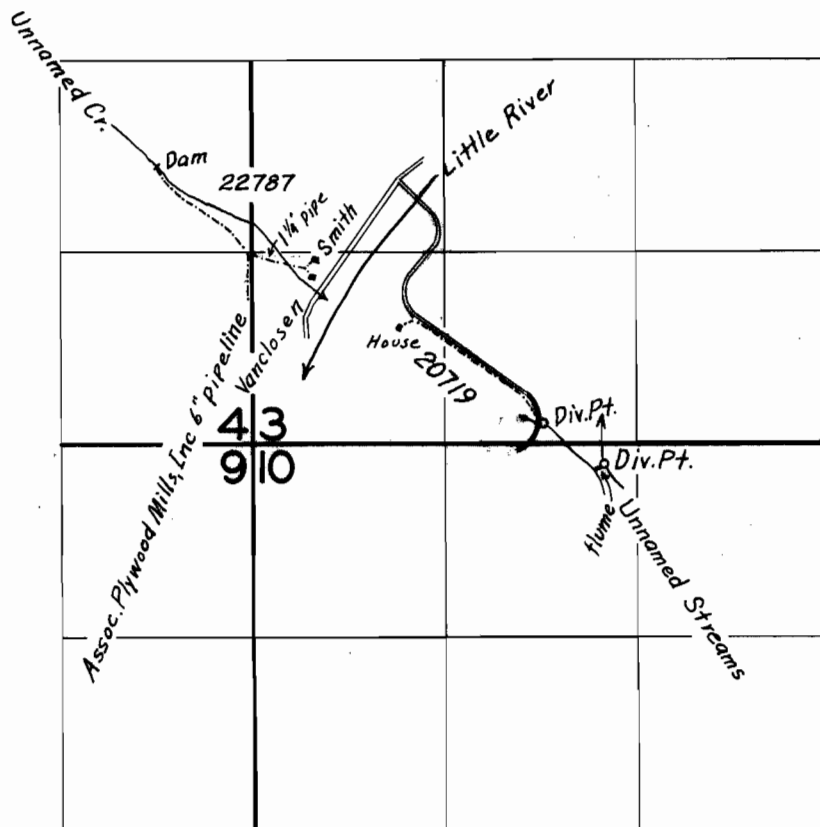

FINAL PROOF SURVEY

UNDER

20719

16198

Application No. 22787..... Permit No. 17946.....

IN NAME OF

Fred Assam

..... Henry M. VonClosen and Richard P. Smith

Surveyed July 25, 1954, by T. Jones.....