


T.18S.R.11W.WM

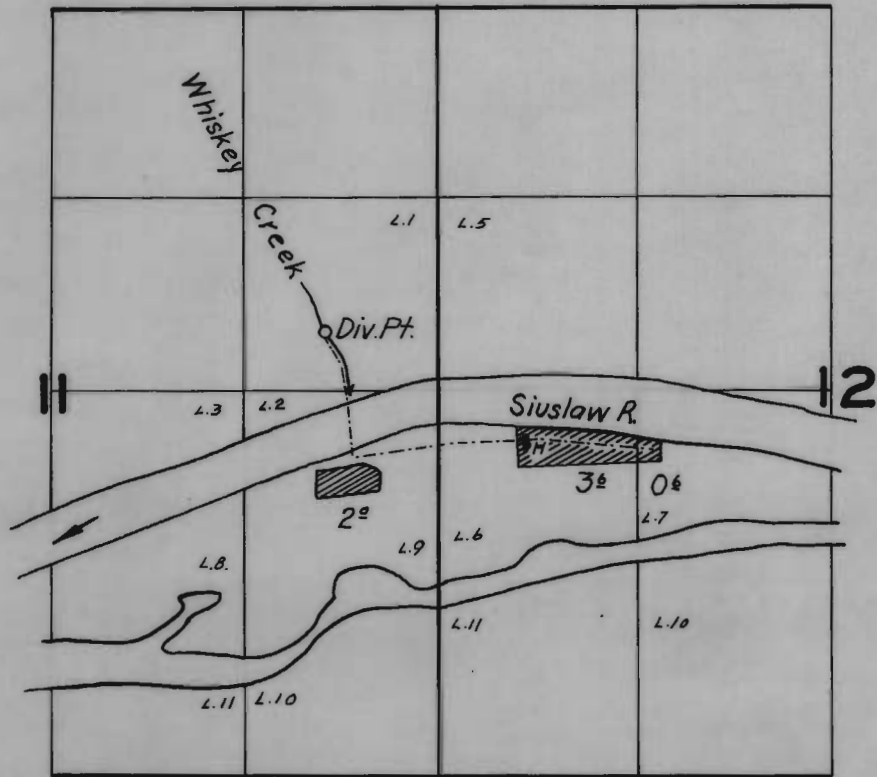

FINAL PROOF SURVEY UNDER

Application No. 20781 Permit No. 16262
IN NAME OF

B. A. Murry

Surveyed Aug. 12 1951, by T. Jones