


T. I. S. R. 3 W. W. M.

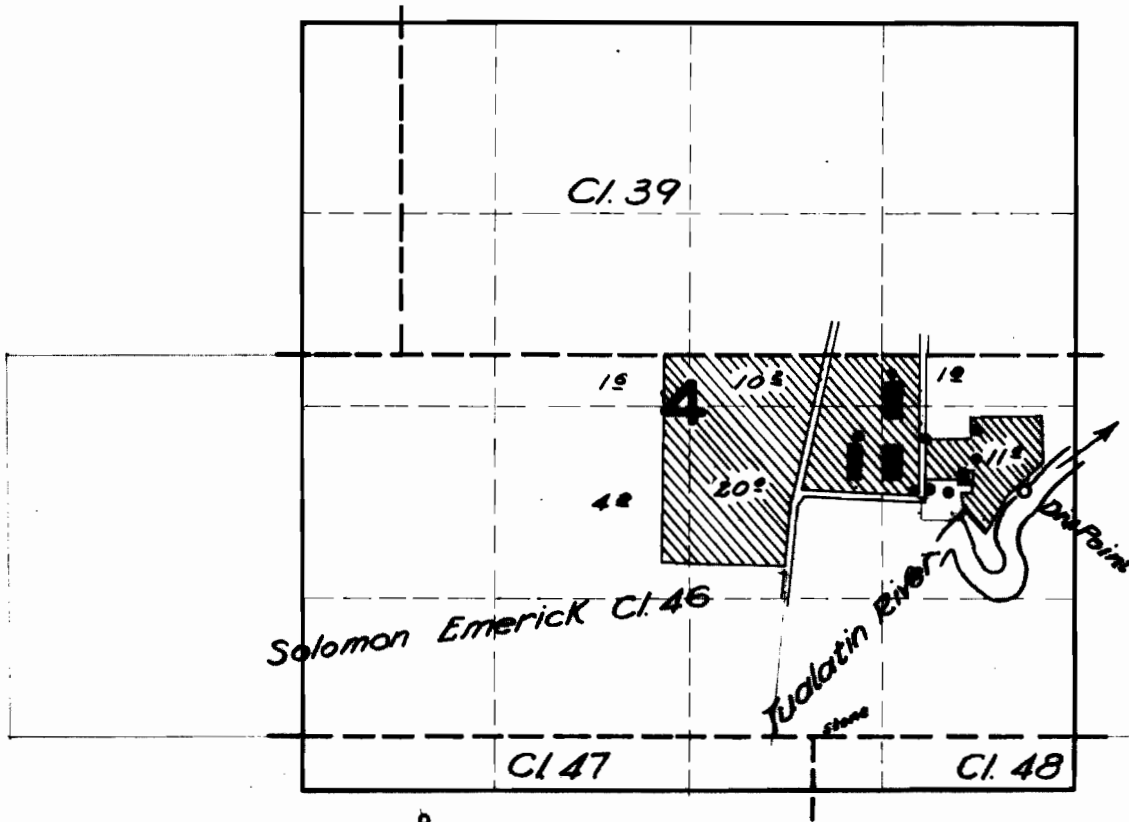

FINAL PROOF SURVEY

UNDER

21020

16442

Application No. 23822..... Permit No. 18775...

File IN NAME OF

WASHINGTON COUNTY FLAX GROWERS

Surveyed May 12, 1952, by H. L. COFFMAN.