
T. 17 S., R. 2 W., W.M.

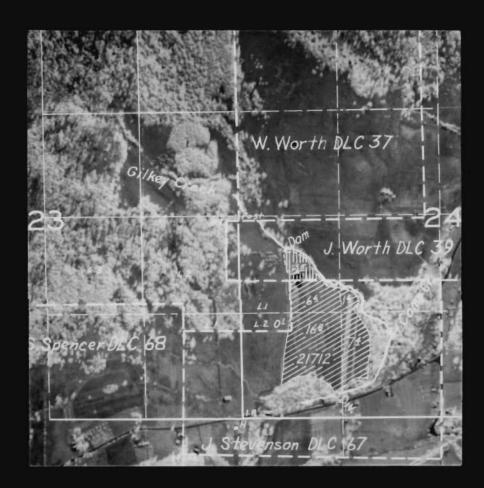

FINAL PROOF SURVEY

UNDER

Application No. 21712 Permit No. 17016 IN NAME OF

Everett C. Swearingen

Surveyed April 23195h , by T. Jones

1000-28-138