


# T.7S. R.3W. WM

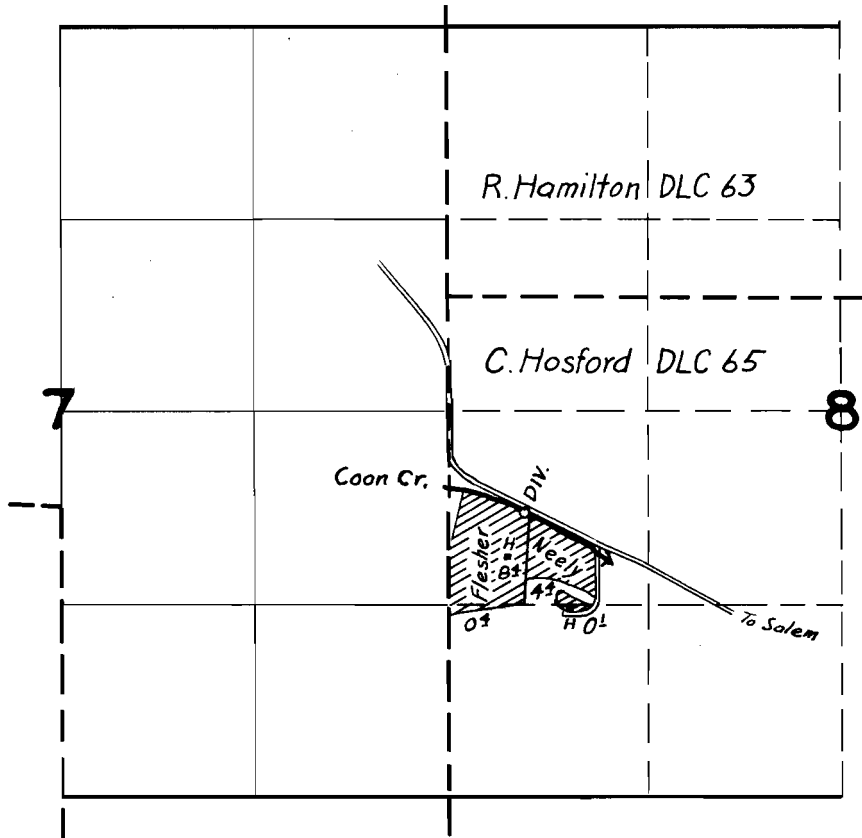

## FINAL PROOF SURVEY UNDER

Application No. 21893..... Permit No. 17239....  
IN NAME OF

Fred B. & Blanche E. Heath & Gurnee Flesher

Surveyed Aug. 19 19 54, by T. Jones.....

BFP-2D-17