


T.22S.R.5W.W.

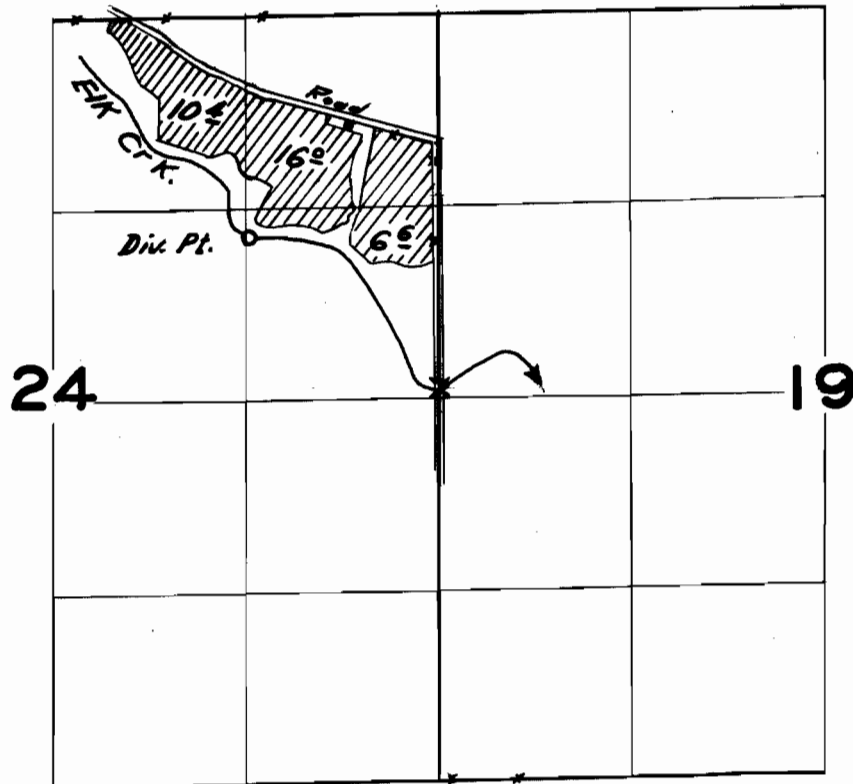

FINAL PROOF SURVEY

UNDER

Application No. 21910 Permit No. 17249

IN NAME OF

Sara D. Land

Surveyed July 26 19 54, by H. L. Coffman.