


T. 6N. R. 35E. W. M.

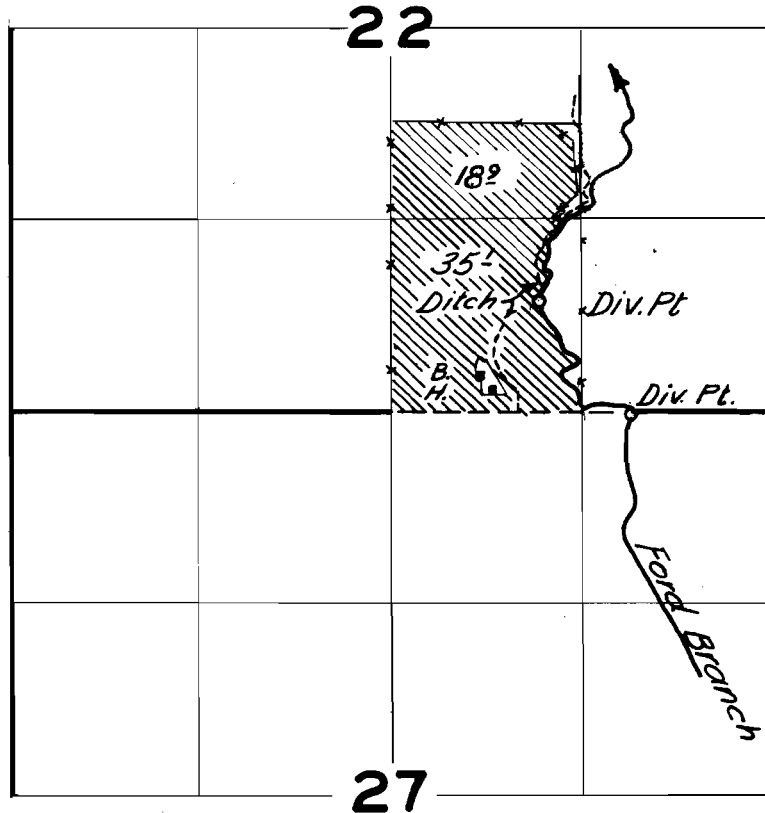

FINAL PROOF SURVEY

UNDER

Application No. 22035..... Permit No. 17357.....

IN NAME OF

J. A. Knopf

Surveyed May 13 19 54, by F. E. Hoffman

12-5F-62