


T.17S.R.7 W.W.M.

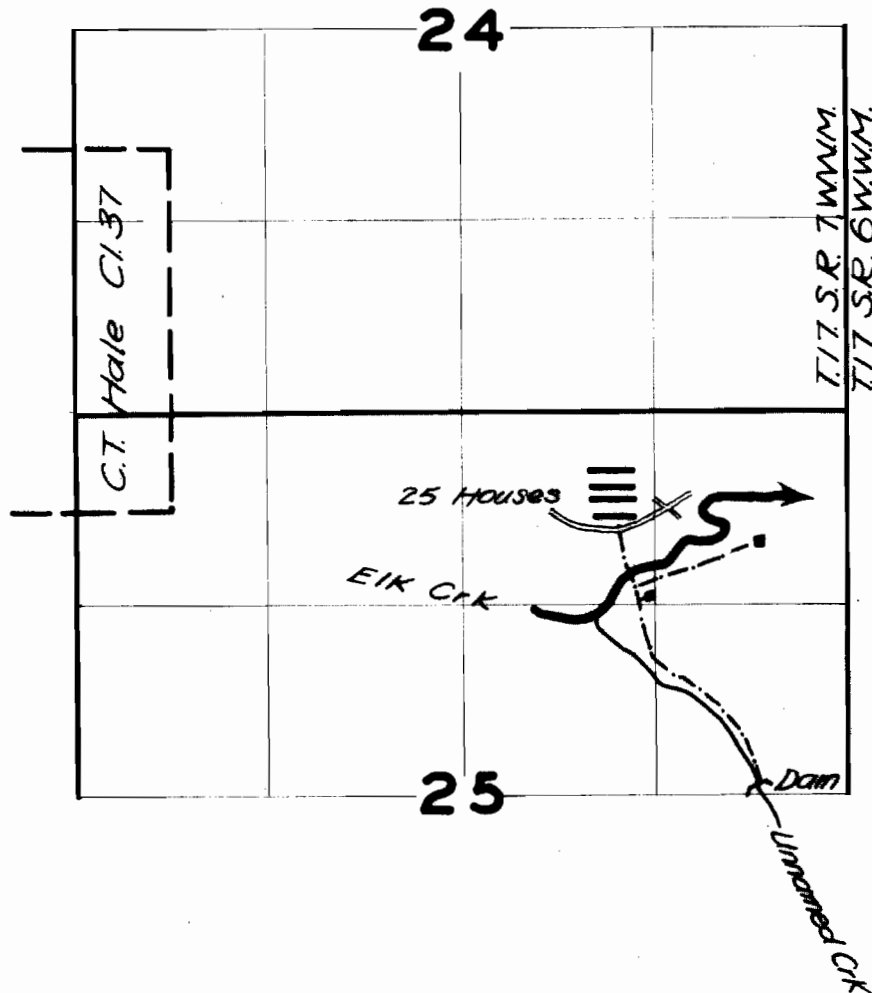

FINAL PROOF SURVEY
UNDER

Application No. 22203..... Permit No. 17484.....
IN NAME OF

.....H. R. and G. H. Swanson.....

Surveyed May 3, 1954, by H. L. Coffman

DDC-8E-137