


T.30S.R.5W.W.M.

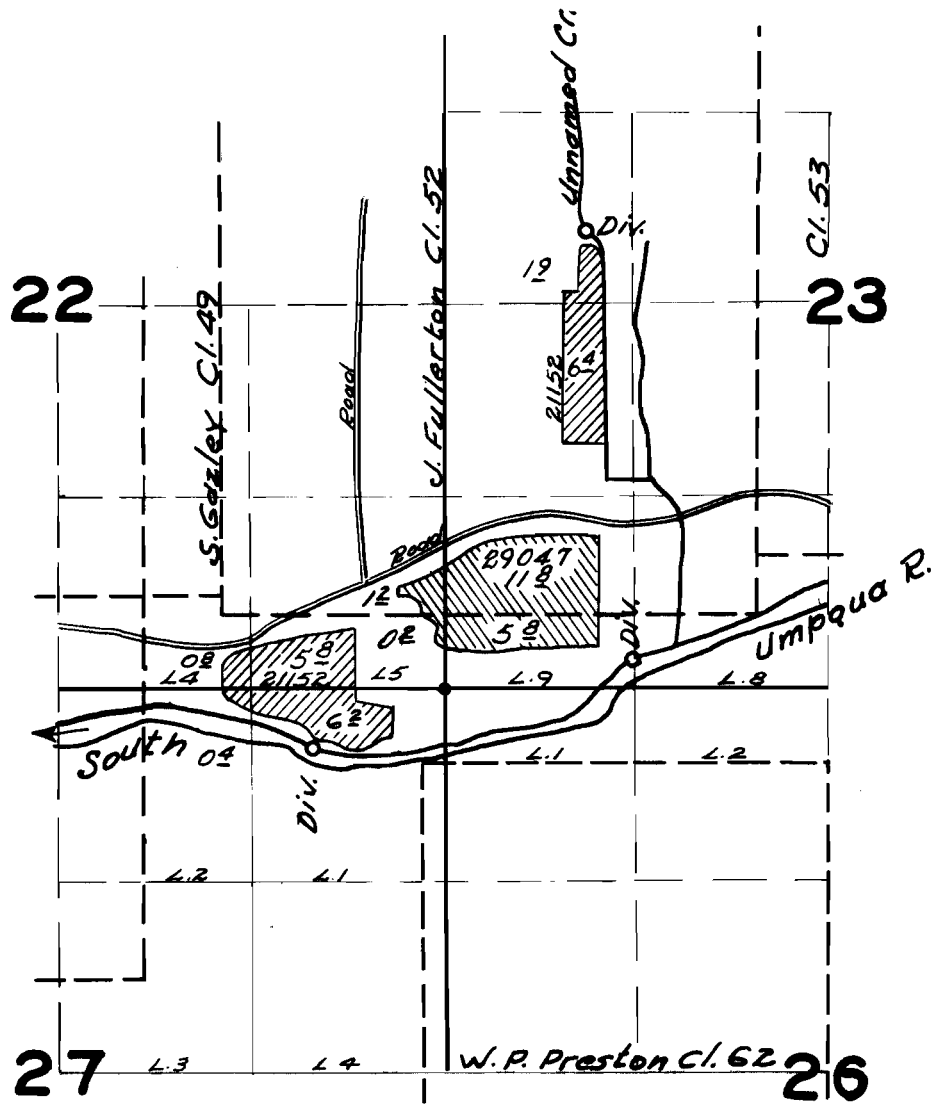

FINAL PROOF SURVEY

UNDER

29047

22848

Application No. 21152

Permit No. 17513

IN NAME OF

Ermel Biggs

Surveyed July 23 1954, by H. L. Coffman

DA-2-11
Pantograph