


T. 19 S., R. 1 W., W.M.

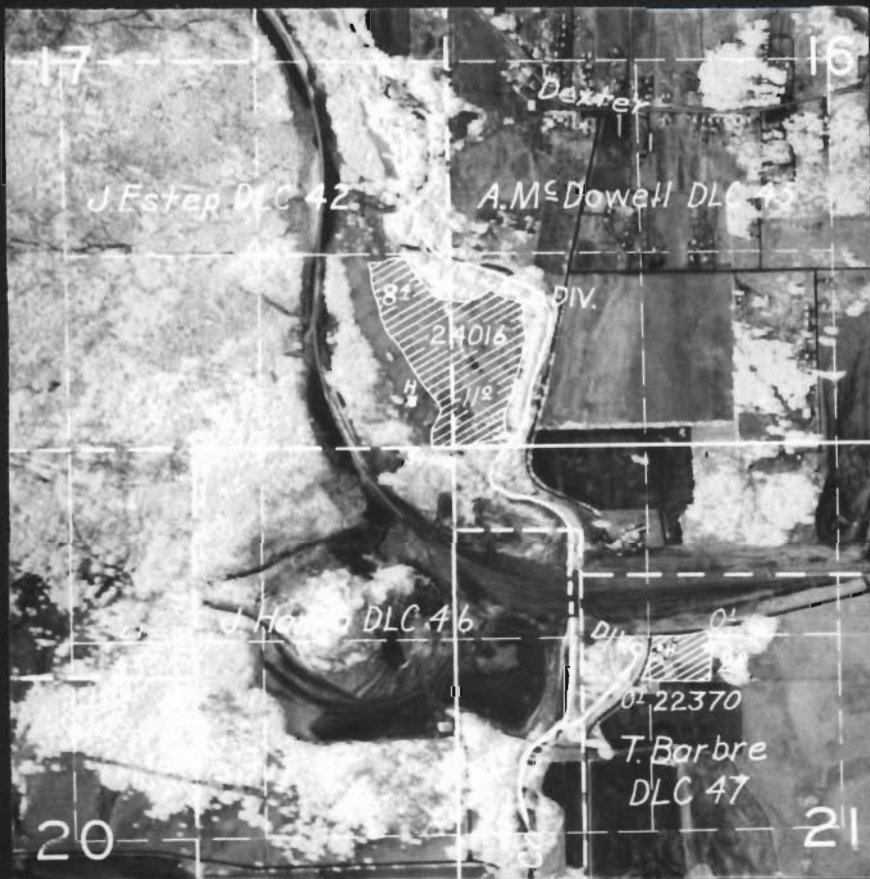

FINAL PROOF SURVEY

UNDER

22370

17637

Application No. 24016 Permit No. 19101

IN NAME OF

C. C. Williams

W. O. Johnson

Surveyed April 27 1954, by T. Jones

BO-5H-57