


T.18S.R.10W.WM

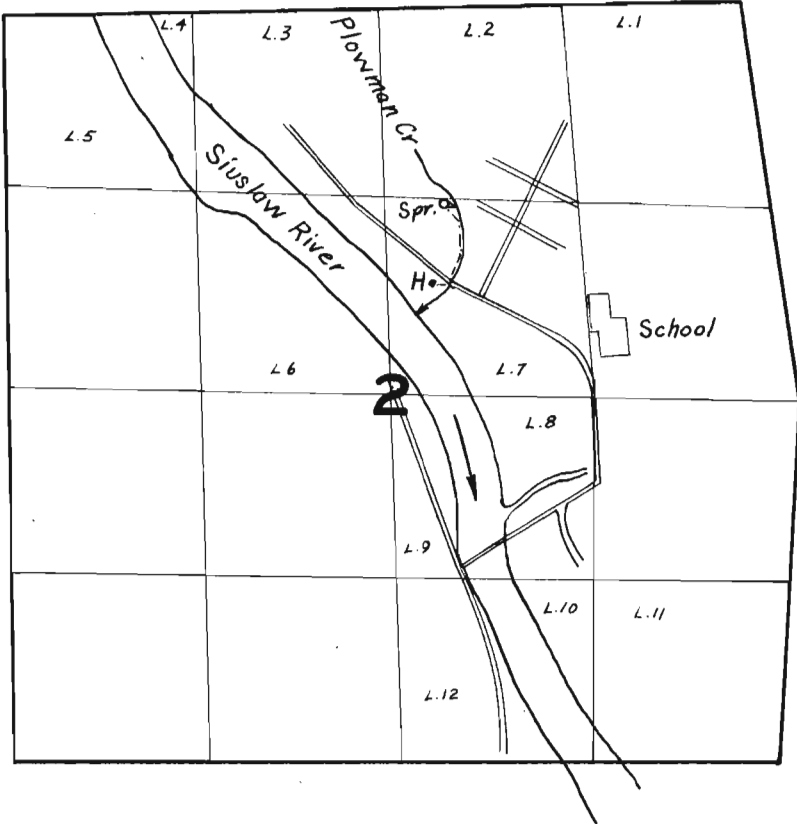

FINAL PROOF SURVEY
UNDER

Application No. 22480..... Permit No. 17720.....
IN NAME OF

Edward H. Campbell & Ruby Estelle Campbell

Surveyed Aug. 12 1954, by T. Jones.....