


T.15S.R.7 W.WM

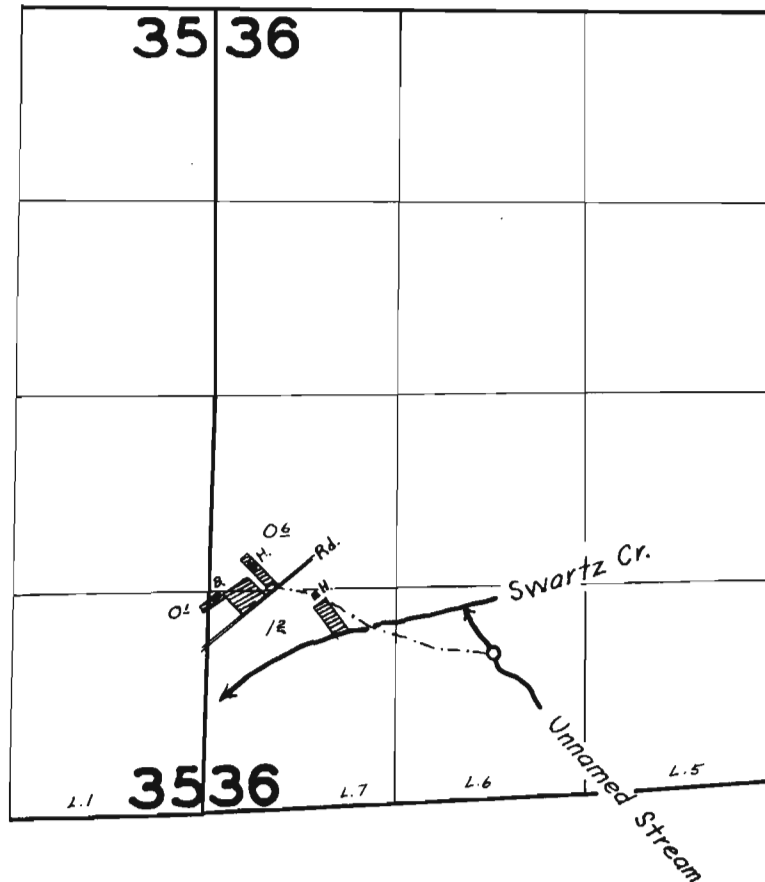

FINAL PROOF SURVEY
UNDER

Application No. 22188 Permit No. 17728
IN NAME OF

John C. Horton

Surveyed April 20 1954, by H. L. Coffman

DBQ-13H-184