


T.13S.R. 26E.W.M.

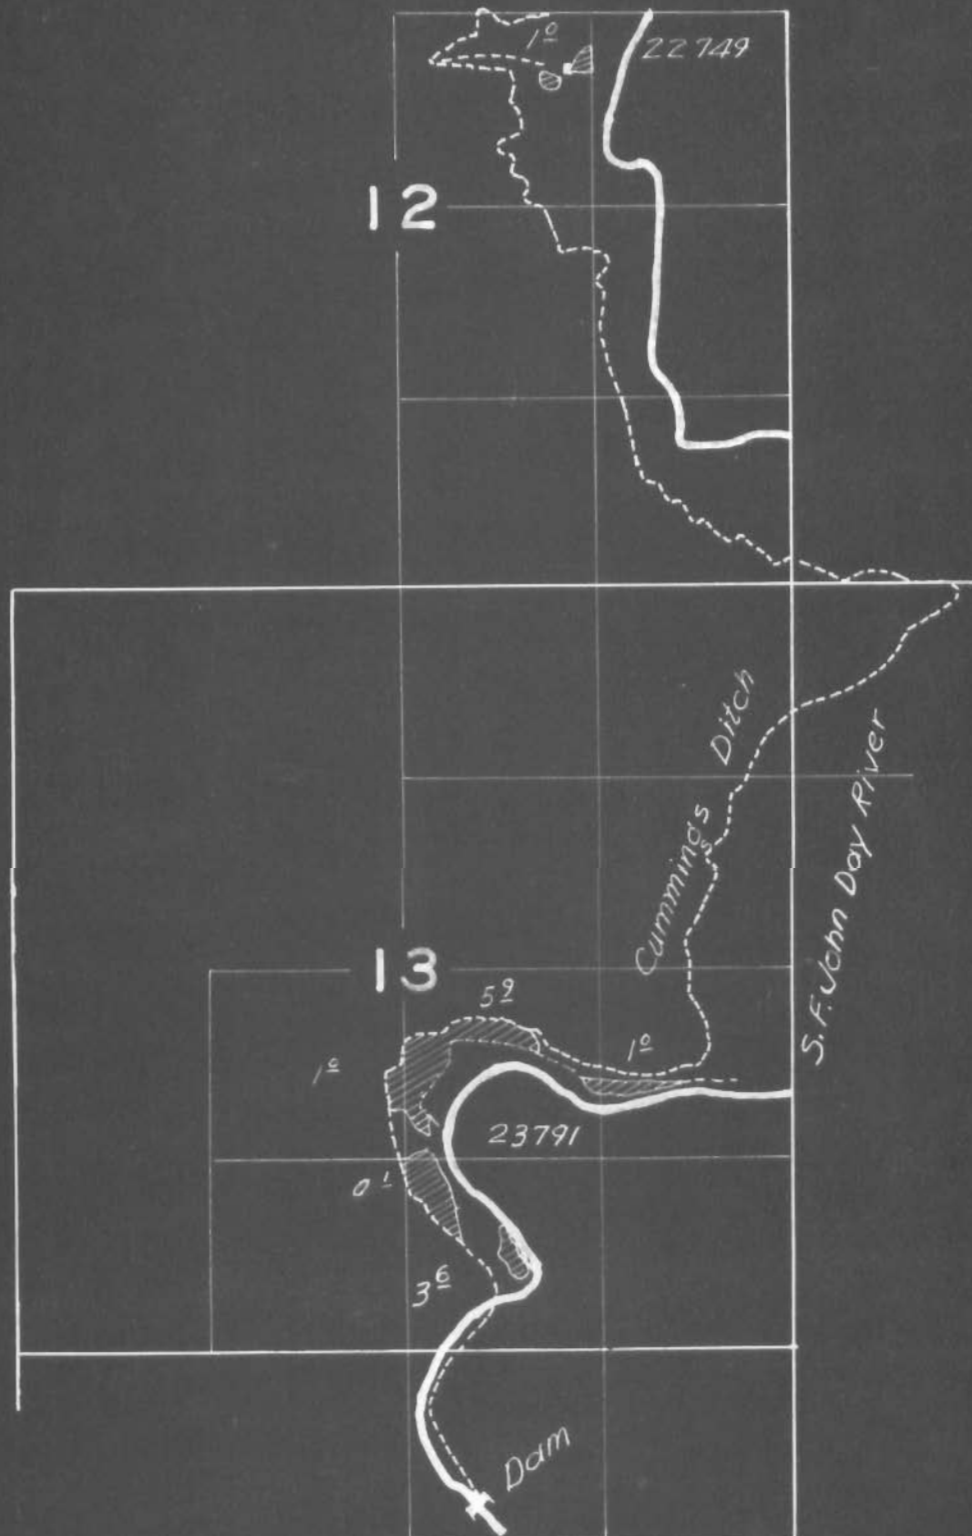

FINAL PROOF SURVEY

24

George S. Black Appl. 22749 Permit 17862
 Geo. MacArthur 23791 18768

Surveyed August 29, 1954 by H. L. Coffman

G6-4
 G5-7
 Pantograph