


T. 17 S., R. 1 W., W.M.

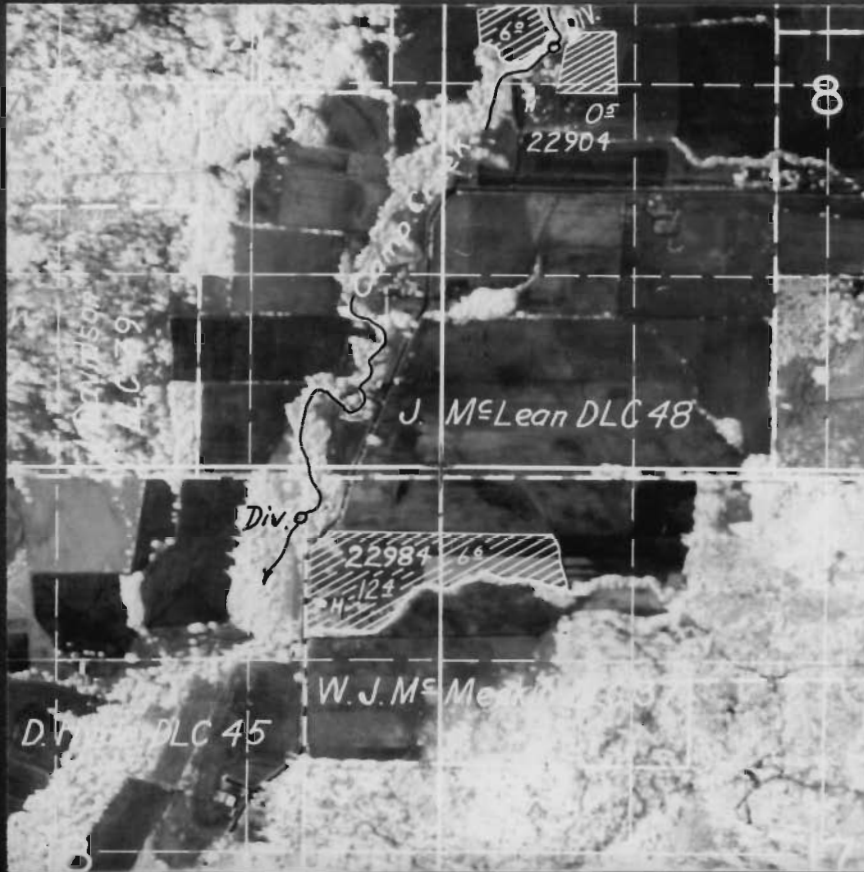

FINAL PROOF SURVEY

UNDER

22984

18097

Application No. 22204 Permit No. 18002

IN NAME OF

George Fisher

Warren Harding Cornelius

Surveyed May 3, 1954, by T. Jones

DBO-5H-70