


T.4S.R.3W.W.M.

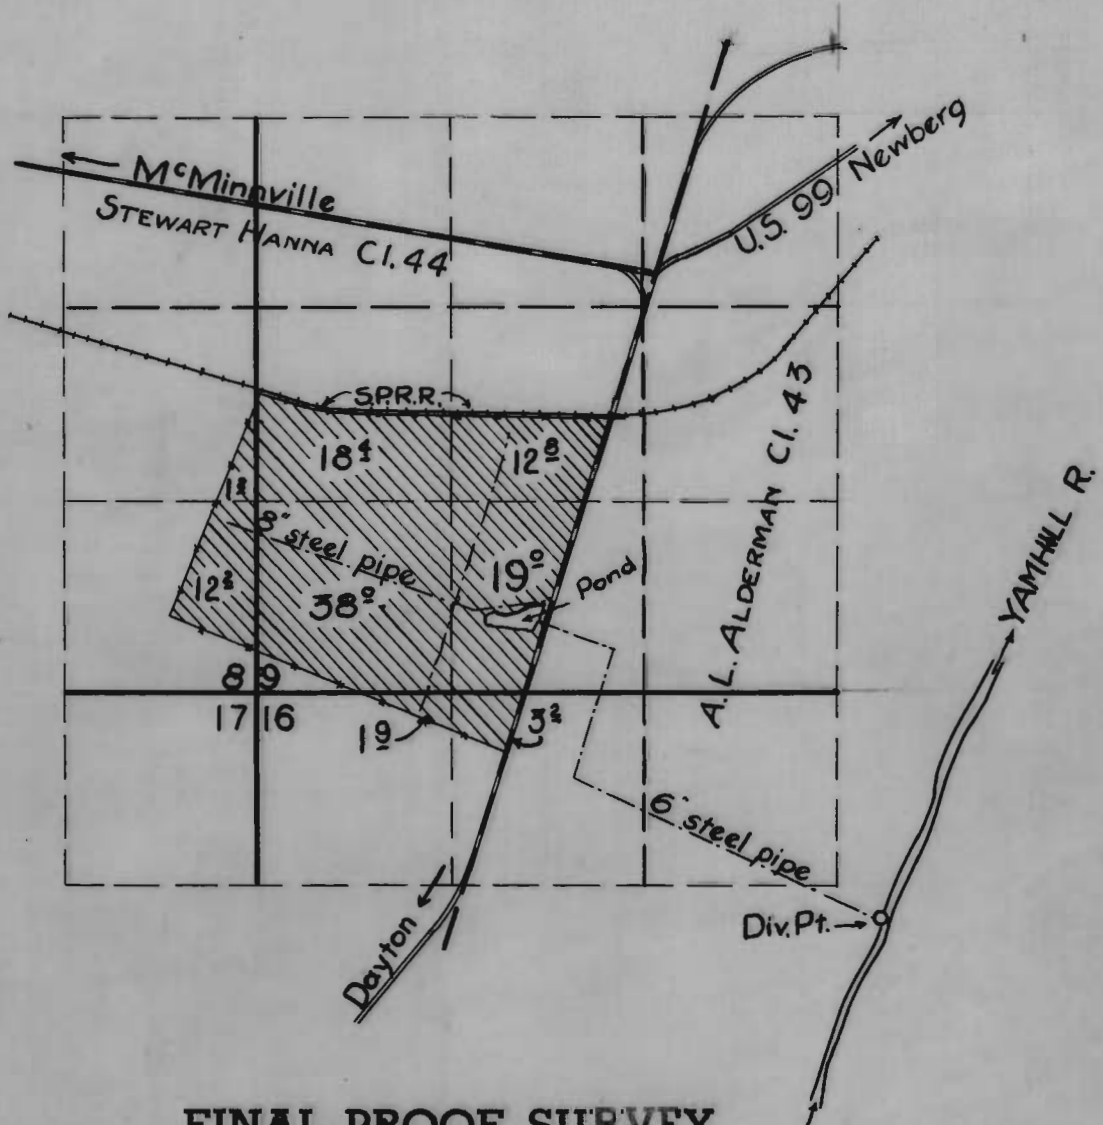

FINAL PROOF SURVEY
UNDER

Application No. 22945 Permit No. 18125

IN NAME OF

KEITH F. COBURN

Surveyed 2 June 1955, by T. Jones