


T. 8 S., R. 3 W., W.M.

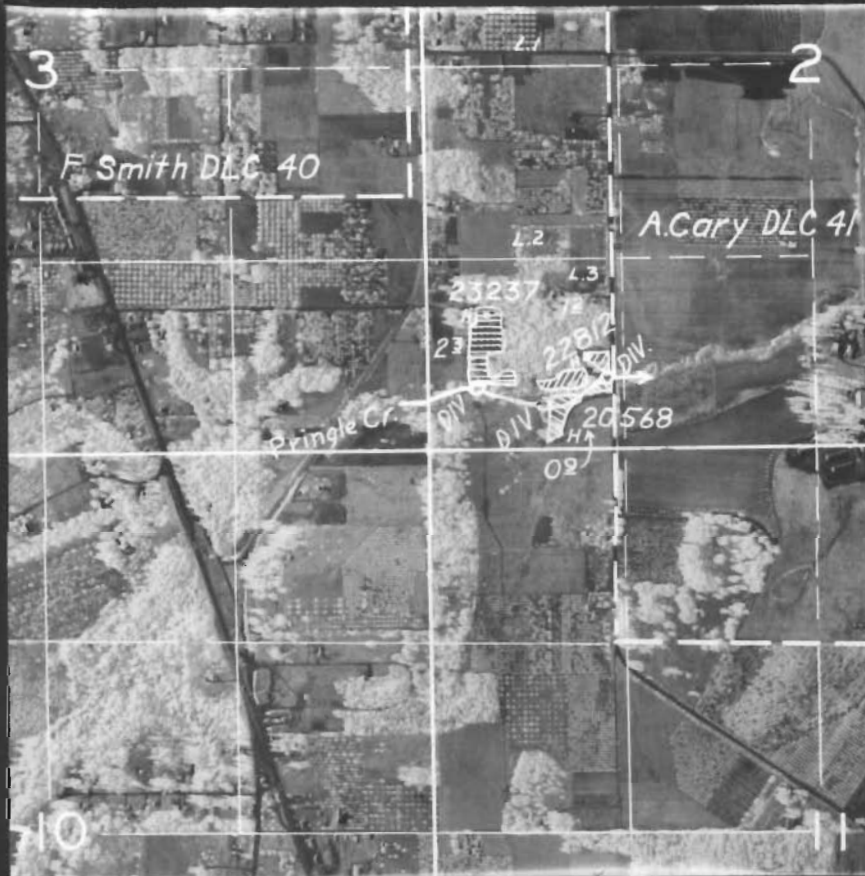

FINAL PROOF SURVEY

Name	Appl. No.	Permit No.
Dr. William L. Lidbeck	20568	16055
F. P. Colgan	23237	18303
W. W. McKinney	22812	18038

Surveyed April 13 1954, by T. Jones.....

DFN 3D 60