


T.30S.R.4W. WM

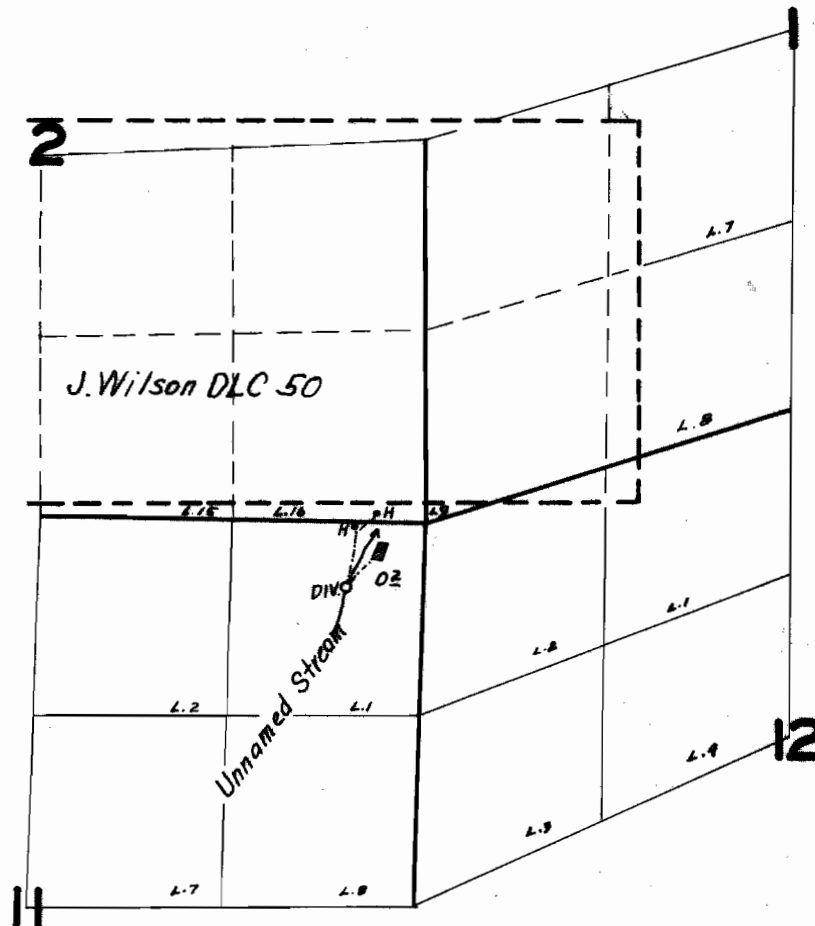

FINAL PROOF SURVEY
UNDER

Application No. 23285 Permit No. 18370
IN NAME OF

Ray F. & Letha May Crawford

Surveyed July 21 1954, by T. Jones

1954-2