


T.9S.R.3E.W.M.

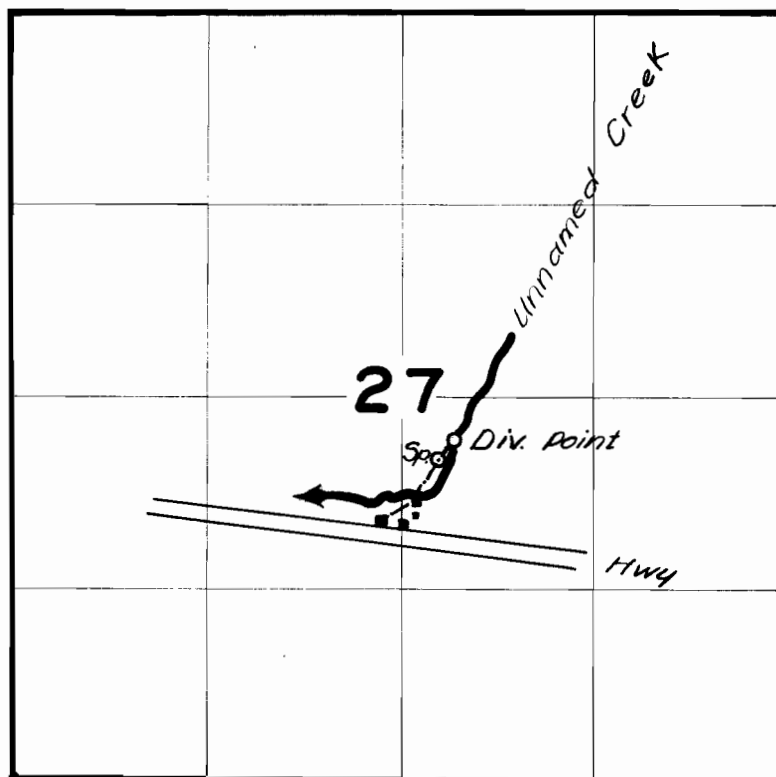

FINAL PROOF SURVEY
UNDER

Application No. 23343 Permit No. 18398
IN NAME OF

Harry D. Evans

Surveyed June 4 1954, by H. L. Goffman