


# T.17S.R.3&4W.WM

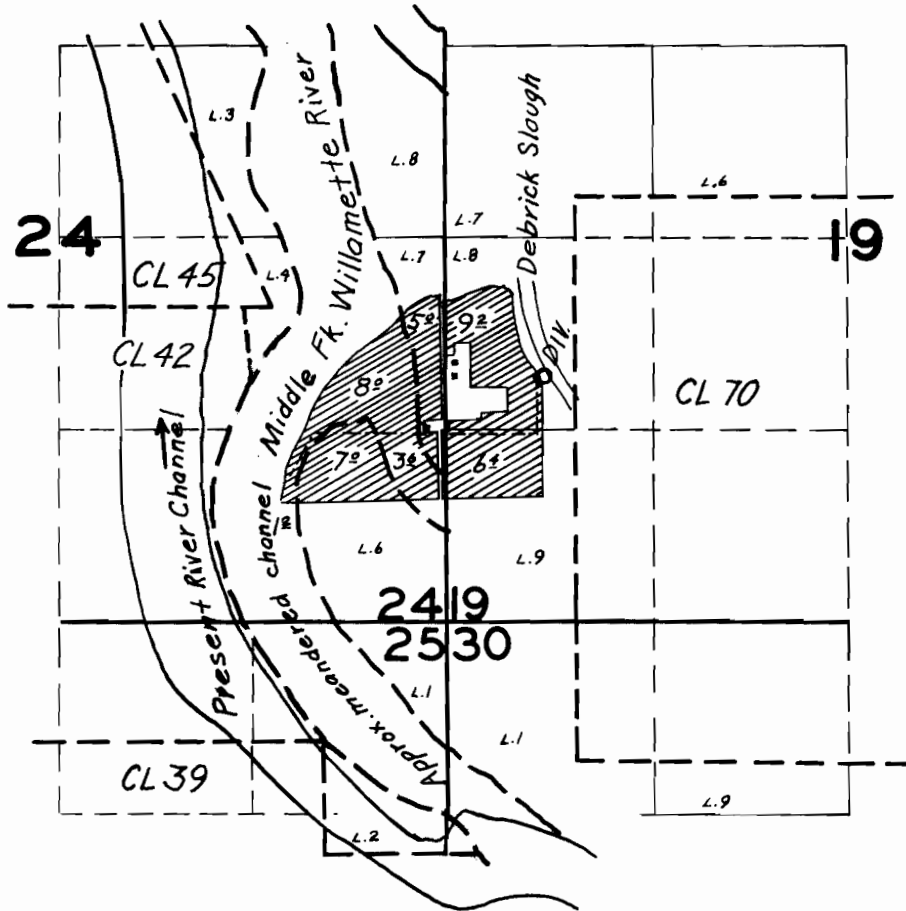

## FINAL PROOF SURVEY

UNDER

Application No. 25427 Permit No. 18491

IN NAME OF

..... et al .....

Surveyed April 28 1954, by J. Janus .....