


T.6N.R.34E.W.M.

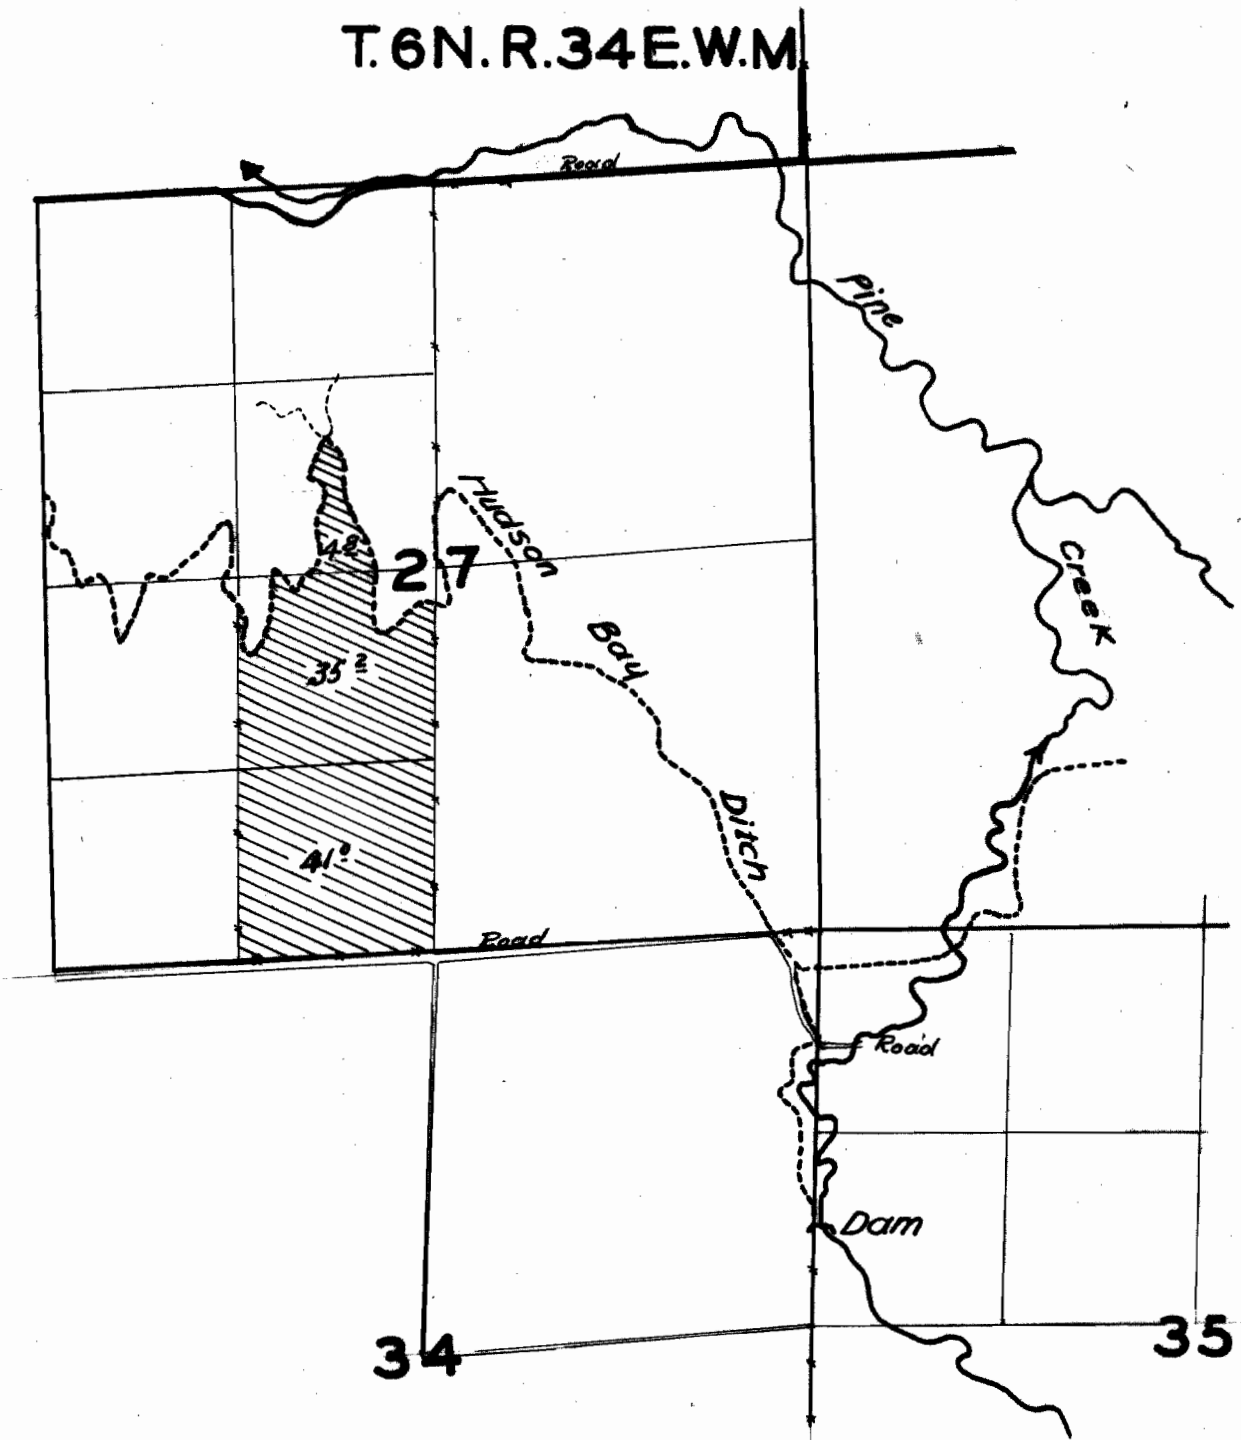

FINAL PROOF SURVEY
UNDER

Application No. 23526 Permit No. 18637

IN NAME OF

Cecil Bryant

Surveyed May 17 1954, by H. L. Coffman

NZ-5F-57