
T. 08., R.5 W., W.M.

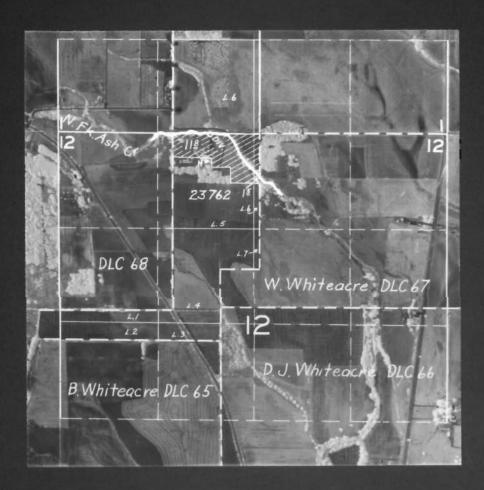

FINAL PROOF SURVEY

UNDER

Application No. 23762 Permit No. 18754 IN NAME OF

Surveyed Aug. 5 1954, by T. Jones