


T.10 & 11 S. R. 1 W. WM

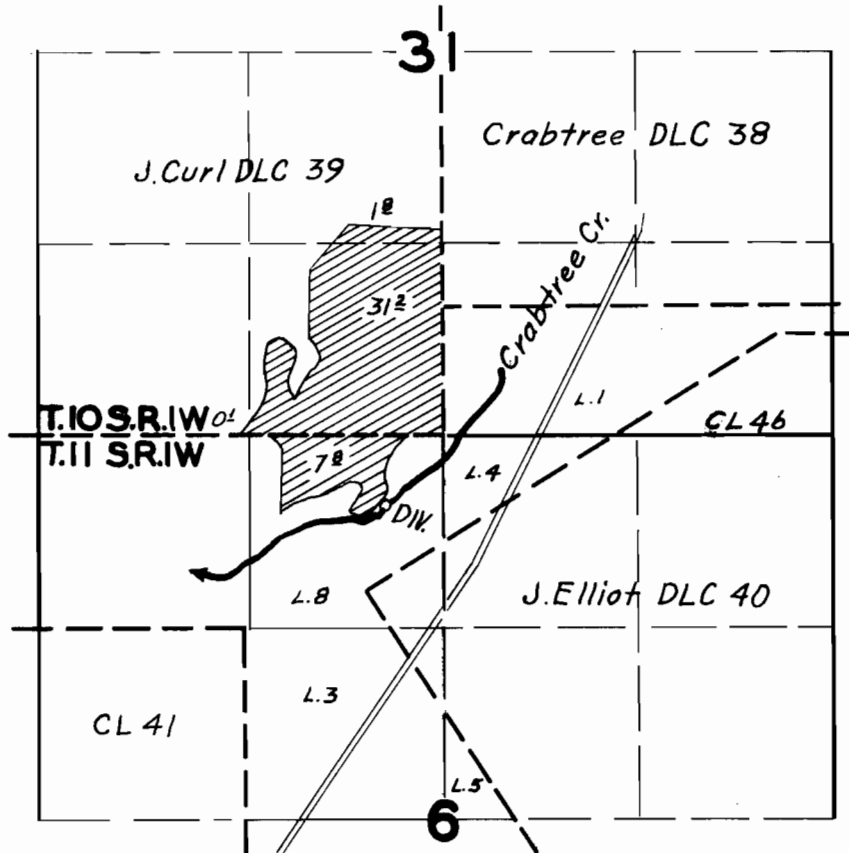

FINAL PROOF SURVEY

UNDER

Application No. 23797 ... Permit No. 18770 ...

IN NAME OF

Fannie, Raymond, Jack & Bessie Kalina

Surveyed Aug. 4, 1954, by H. L. Coffman