


T. 28 S. R. 7 W. WM

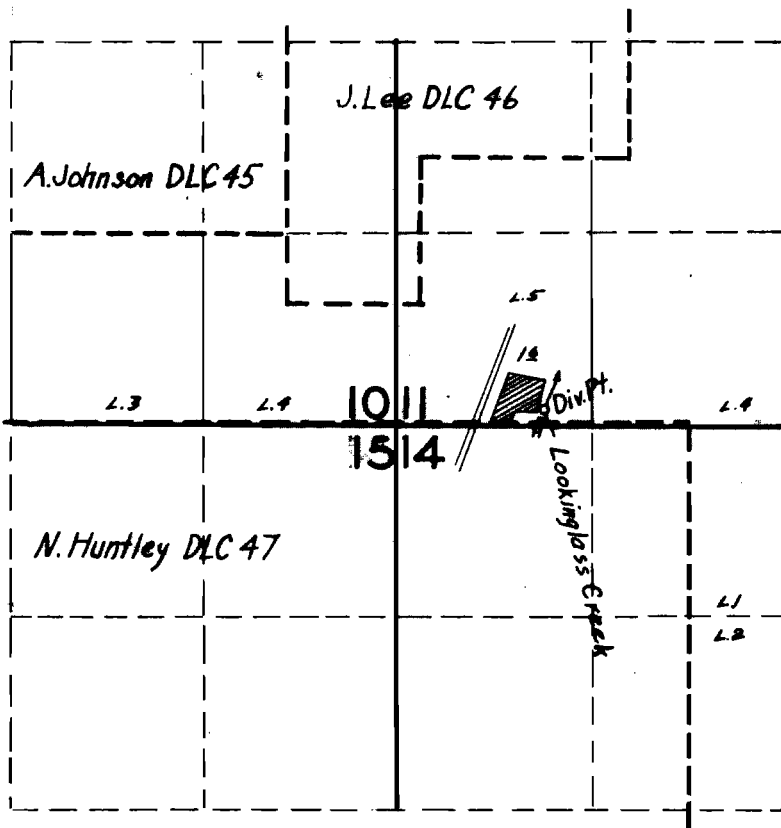

FINAL PROOF SURVEY UNDER

Application No. 23952..... Permit No. 18857.....

IN NAME OF

.....Granville Hampton.....

Surveyed July 24, 1954, by T. Jones.....