


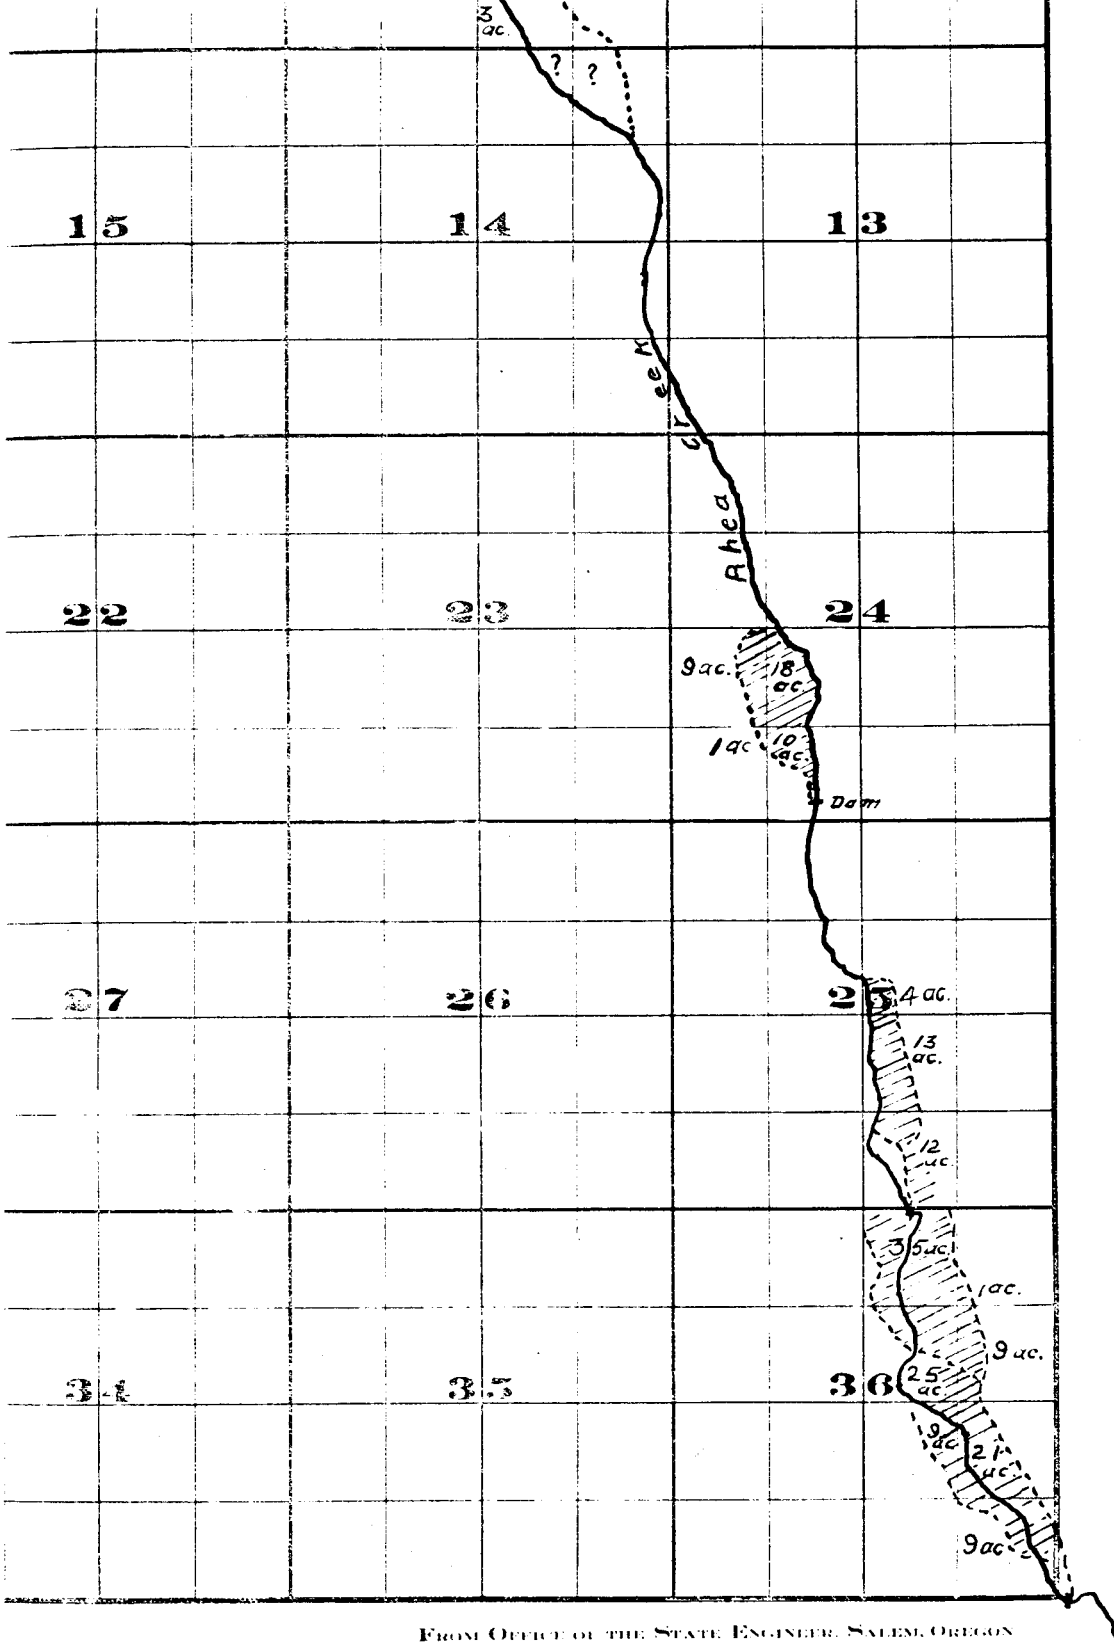

2 S. 24 E.

Township 2 S.

[illegible]

Range 24 E.W.M.

