


T. 3N.R. 28E.W.M.

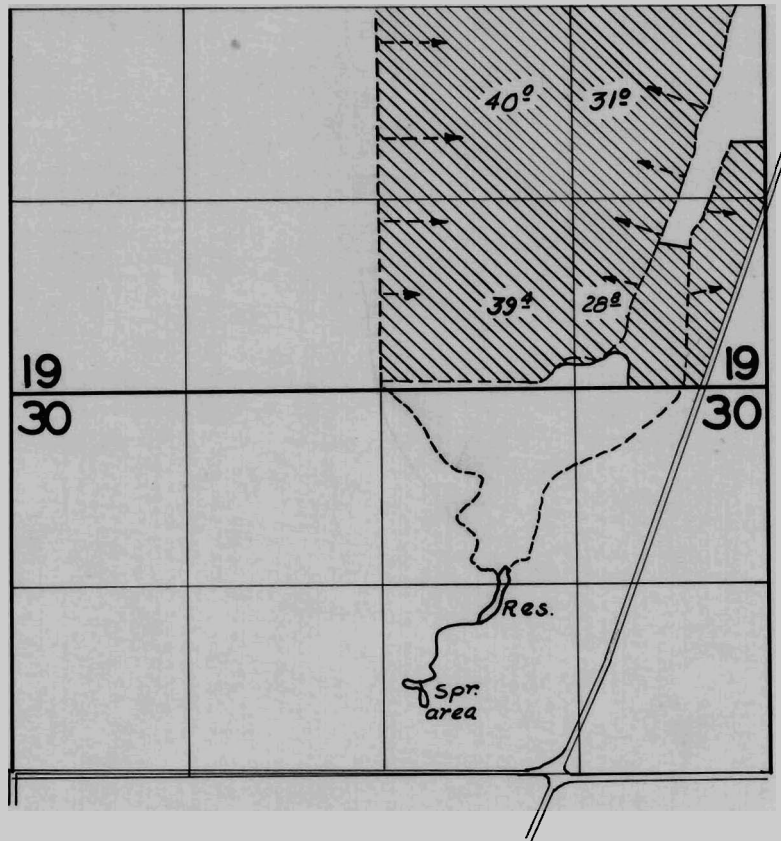

FINAL PROOF SURVEY
UNDER

Application No. 23960 Permit No. 18912
IN NAME OF

GAYLORD M. MADISON

Surveyed MAY 12 1954, by T. JONES