


T. 8 S., R. 5 W., W.M.

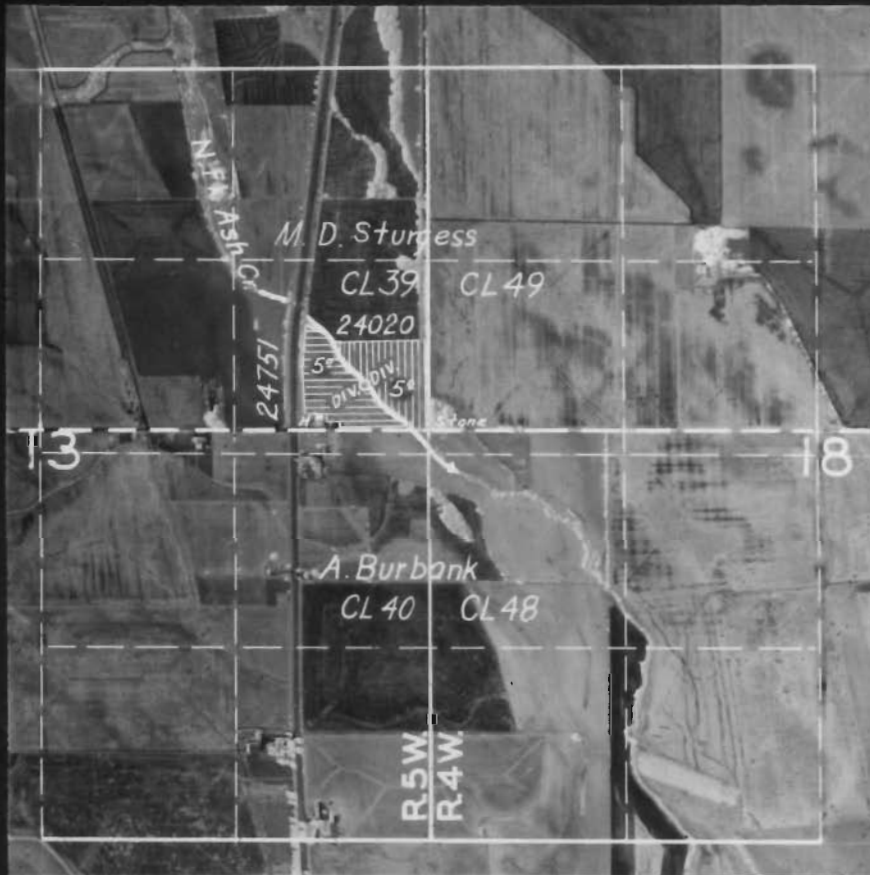

FINAL PROOF SURVEY

UNDER

Application No. 24020 Permit No. 18940
24751 19514

IN NAME OF

F. A. Lowry

Surveyed Aug. 4, 1954, by T. Jones

DAP-2D-133