


T.22 S.R.5 W.W.M.

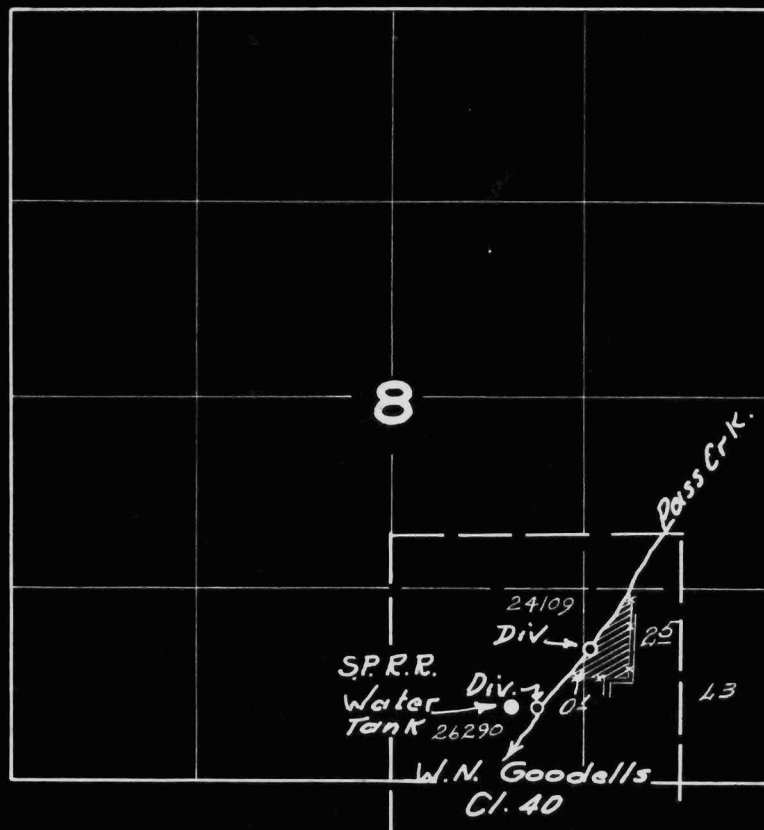

FINAL PROOF SURVEY

UNDER

26290

20635

Application No. 24109 Permit No. 18984

IN NAME OF

Southern Pacific Company

Alvin M. Cornett

Surveyed July 26, 1954, by H. L. Coffman

DB-HW-34-15