T. 27 & 28 S. R. 5 W.W.M.

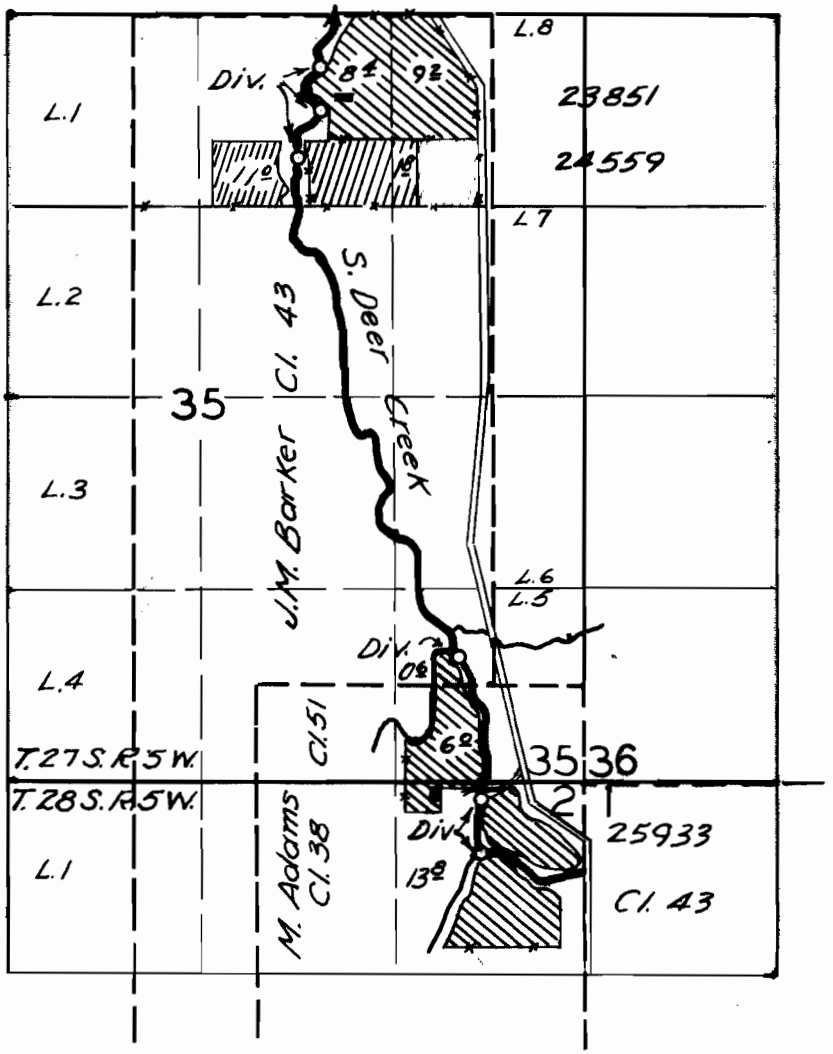

FINAL PROOF SURVEY

25933 20337
28851 22696

Application No. 24559 Permit No. 19320

Howard Hatfield
Edward W. H. Smith
Eileen McLaughlin Smith

Surveyed July 21 1954, by H. L. Coffman

DC-4-46
Pantograph