


T.10S.R.4W.WM

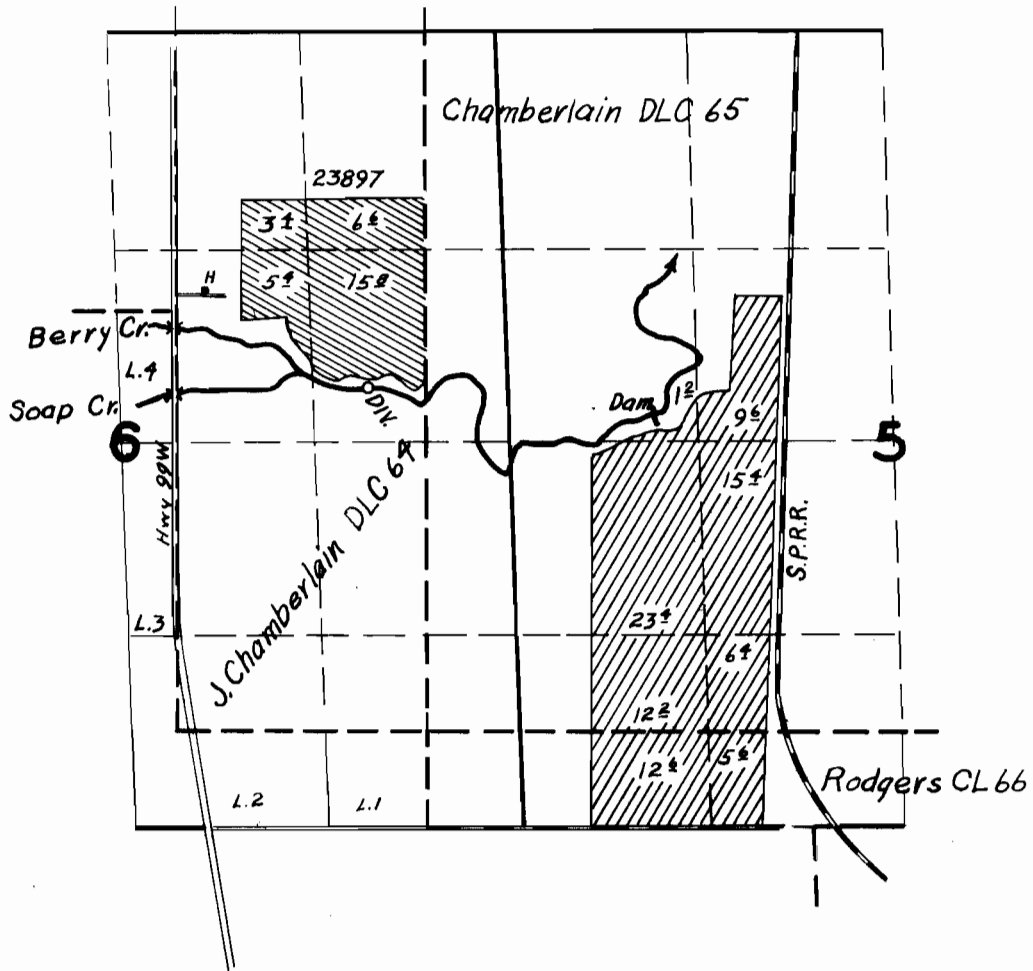

FINAL PROOF SURVEY

23897 19332

22827 18044

Application No. R-22826 Permit No. R-911

IN NAME OF

George W. Gordon

Owen Cook

Surveyed Aug. 6, 1954, by T. Jones

DFP-2D-115