


T.10S.R.2W.WM

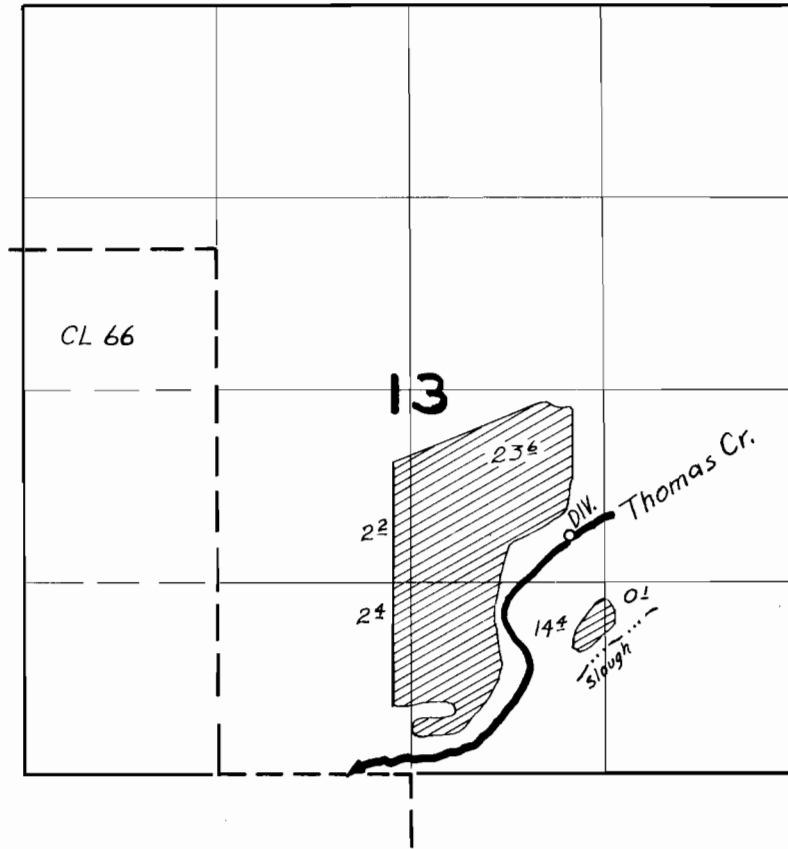

FINAL PROOF SURVEY

UNDER

Application No. 24594 ... Permit No. 19377...

IN NAME OF

Henry and Iva Novak

Surveyed July 14, 1954, by H. A. Coffman

DE-20-130